

ADDENDUM #2

Project : Layton City Welker Trailhead Improvements, Project 22-02
(2700 N. 2125 E. – Layton, UT 84041)

From: JoEllen Grandy, Parks Planner
Layton City Parks & Recreation
465 N. Wasatch Dr.
Layton, UT 84041
801.336.3926
jgrandy@laytoncity.org

Date: June 1, 2023

Re: Request for Information

1. The Parking Lot Lights are to be changed to the following model:

Lithonia DSX1 LED P3 40K T4M MVOLT SPA DBLXD 25 FT. SQUARE ALUMINUM HINGE BASE POLE
DBLXD 100MPH + GUSTS WIND RATING. Mounting: Pole, Pole Base. Lamps LED (102W)

2. Where is existing City power located? RMP generally requires 2- 4" conduits for a 400 AMP service, and are they providing the wire?

See the attached pdf for clarifications on Sheets ES101, ES601 and ES602. (Service is to be single phase.)

RMP will provide the wire from the transformer to the secondary box. Contractor is to install the 3" conduit from the transformer to the secondary box. Contractor is also responsible for installing the 2" conduit and wire from the secondary box to the meter.



DEFERRED SUBMITTALS

Delegated Deferred Design Submittals to be provided by Contractor

OVERCURRENT PROTECTIVE DEVICE STUDY AND ARC-FLASH STUDY REPORT & LABELING

Provide the following items listed below and comply with additional requirements as provided. See specifications.

- Coordination-study input data, including completed computer program input data sheets.
- Study and equipment evaluation reports.
- Overcurrent protective device coordination study report, signed, dated, and sealed by a qualified professional engineer. Overcurrent protection shall coordinate to 0.3 seconds on normal power and to 0.1 seconds on emergency power.
- Arc-flash study input data, including completed computer program input data sheets.
- Arc-flash study report, signed, dated, and sealed by a qualified professional engineer.
 - Submit study report for action prior to receiving final approval of the distribution equipment submittals. If formal completion of studies will cause delay in equipment manufacturing, obtain approval from Architect for preliminary submittal of sufficient study data to ensure that the selection of devices and associated characteristics is satisfactory.

SEISMIC CONTROL FOR ELECTRICAL SYSTEMS

Provide the following items listed below and comply with additional requirements as provided. See specifications.

- A. Product Data: For each type of product.
- Illustrate and indicate style, material, strength, fastening provision, and finish for each type and size of seismic-restraint component used.
 - Tabulate types and sizes of seismic restraints, complete with report numbers and rated strength in tension and shear as evaluated by an agency acceptable to authorities having jurisdiction.
 - Annotate to indicate application of each product submitted and compliance with requirements.
- B. Delegated-Design Submittal: For each seismic-restraint device.
- Include design calculations and details for selecting seismic restraints complying with performance requirements, design criteria, and analysis data signed and sealed by the qualified professional engineer responsible for their preparation.
 - Design Calculations: Calculate static and dynamic loading caused by equipment weight, operation, and seismic and wind forces required to select seismic and wind restraints and for designing vibration isolation bases.
 - Coordinate design calculations with wind load calculations required for equipment mounted outdoors. Comply with requirements in other Sections for equipment mounted outdoors.
 - Seismic-Restraint Details:
 - Design Analysis: To support selection and arrangement of seismic restraints. Include calculations of combined tensile and shear loads.
 - Details: Indicate fabrication and arrangement. Detail attachments of restraints to the restrained items and to the structure. Show attachment locations, methods, and spacings. Identify components, list their strengths, and indicate directions and values of forces transmitted to the structure during seismic events. Indicate association with vibration isolation devices.
 - Coordinate seismic-restraint and vibration isolation details with wind-restraint details required for equipment mounted outdoors. Comply with requirements in other Sections for equipment mounted outdoors.
 - Preapproval and Evaluation Documentation: By an agency acceptable to authorities having jurisdiction, showing maximum ratings of restraint items and the basis for approval (tests or calculations).

C. Deferred Submittals for the Authority Having Jurisdiction (AHJ) shall be as required by IBC 106.3.4.2.

1. Deferred submittals of seismic restraint of nonstructural components must be submitted to the AHJ a minimum of two weeks prior to the planned installation in order to allow for plan review and forwarding to inspectors. In the event that the submittal is deficient additional time may become necessary.

2. No deferred submittal element shall be installed until AHJ approval has been received.

3. If seismic restraints of nonstructural components are installed prior to receiving AHJ approval they shall not be covered or concealed until plan review and inspection approval. Further, installers are proceeding at their own risk until plan review and inspection approval occurs.

4. Deferred Submittals are required for:
- Electrical distribution equipment (switchboards, panelboards, transformers, ATS, MCC's etc.).
 - Generators, batteries, UPS.
 - Conduit racks.
 - Cable trays.
 - Lighting fixtures.
 - Control Panels

GENERAL LABELING SCHEME

FIRST DIGIT - BUILDING LEVEL (1 OR 2)

SECOND DIGIT - PANEL TYPE

M - MECHANICAL (120/208/277/380/480V)
 L or LCP - LIGHTING (120/208/277/480V)
 P - PLUG LOADS (120/208V)
 G - GENERAL LOADS (120/280V)
 E - EMERGENCY (277/480V)
 S - STANDBY (SPECIFIED ON PANEL)
 U - UPS (SPECIFIED ON PANEL)

THIRD DIGIT - BUILDING AREA (A, B, C, D, ECT.)

FOURTH DIGIT - SEQUENCE # (1,2,3...)

ABBREVIATIONS

NOTE: ALL ABBREVIATIONS MAY NOT BE USED.

1P	SINGLE POLE	I/O	INPUT/ OUTPUT
1PH	SINGLE-PHASE	IG	ISOLATED GROUND
1WAY	ONE-WAY	IMC	INTERMEDIATE METAL CONDUIT
2/C	TWO-CONDUCTOR	IN/IS	INSULATED/ ISOLATED
2WAY	TWO-WAY	IR	INFRARED
3/C	THREE-CONDUCTOR	J-BOX	JUNCTION BOX
3WAY	THREE-WAY	KV	KILOVOLT
4OUT	QUADRUPE RECEPTACLE OUTLET	KVA	KILOVOLT AMPERE
4PDT	FOUR-POLE DOUBLE THROW	KVAR	KILOVOLT AMPERE REACTIVE
4PST	FOUR-POLE SINGLE THROW	KW	KILOWATT
4W	FOUR-WIRE	KWh	KILOWATT HOUR
4WAY	FOUR-WAY	LED	LIGHT EMITTING DIODE
A	ABOVE COUNTER	LFMC	LIQUID TIGHT FLEXIBLE METAL CONDUIT
AC	ARMORED CABLE	LFNC	LIQUID TIGHT FLEXIBLE NONMETALLIC CONDUIT
ADA	AMERICANS WITH DISABILITIES ACT	LPS	LOW PRESSURE SODIUM
ADJ	ADJACENT	LRA	LOCKED ROTOR AMPS
AFF	ABOVE FINISHED FLOOR	LTG	LIGHTING
AFG	ABOVE FINISHED GRADE	LV	LOW VOLTAGE
AIC	AMPERE INTERRUPTING CAPACITY	MATV	MASTER ANTENNA TELEVISION SYSTEM
ALUM	ALUMINUM	MAX	MAXIMUM
AMP	AMPERE	MC	METAL CLAD
ANN	ANNUNCIATOR	MCA	MINIMUM CIRCUIT AMPS
AP	ACCESS POINT (WIRELESS DATA)	MCB	MAIN CIRCUIT BREAKER
AR	AS REQUIRED	MCC	MOTOR CONTROL CENTER
ASC	AMPS SHORT CIRCUIT	MCP	MOTOR CIRCUIT PROTECTION
ATS	AUTOMATIC TRANSFER SWITCH	MDP	MAIN DISTRIBUTION PANEL
AV	AUDIO VISUAL	MG	MOTOR GENERATOR
AWG	AMERICAN WIRE GAGE	MH	MANHOLE
BB	BUCK-BOOST	MIN	MINIMUM
XFMR	TRANSFORMER	MLO	MAIN LUGS ONLY
C	CEILING MOUNTED	MCCP	MAXIMUM OVERCURRENT PROTECTION
CATV	COMMUNITY ANTENNA TELEVISION	NA	NOT APPLICABLE
CB	CIRCUIT BREAKER	NC	NORMALLY CLOSED
CCBA	CUSTOM COLOR AS SELECTED BY ARCHITECT	NEC	NATIONAL ELECTRICAL CODE
CCTV	CLOSED CIRCUIT TELEVISION	NEMA	NATIOANL ELECTRICAL CONTRACTORS ASSOCIATION
CF/CI	CONTRACTOR FURNISHED/ CONTRACTOR INSTALLED	NFC	NATIONAL FIRE CODE
CF/OI	CONTRACTOR FURNISHED/ OWNER INSTALLED	NFPA	NATIONAL FIRE PROTECTION ASSOCIATION
CFBA	CUSTOM FINISH AS SELECTED BY ARCHITECT	NIC	NOT IN CONTRACT
CKT	CIRCUIT	NL	NIGHT LIGHT
CM	CONSTRUCTION MANAGER	NO	NORMALLY OPEN
CND	CONDUIT	NTS	NOT TO SCALE
CO	CONVENIENCE OUTLET	OC	ON CENTER
COR	CONTRACTING OFFICER'S REPRESENTATIVE	OCP	OVER CURRENT PROTECTION
CP	CONTROL PANEL	OF/CI	OWNER FURNISHED/ CONTRACTOR INSTALLED
CT	CURRENT TRANSFORMER	OF/OI	OWNER FURNISHED/ OWNER INSTALLED
CTV	CABLE TELEVISION	OFF	OBTAIN FROM PLANS
CU	COPPER	OH DR	OVERHEAD (COILING) DOOR
dba	UNIT OF SOUND LEVEL	OL	OVERLOAD
DPDT	DOUBLE POLE, DOUBLE THROW	PB	PUSHBUTTON
DS	DISCONNECT SWITCH	PF	POWER FACTOR
EA	EACH	PH	PHASE
EM	EMERGENCY	PNL	PANEL
EMT	ELECTRICAL METALLIC TUBING	PT	POTENTIAL TRANSFORMER
ENT	ELECTRIC NONMETALLIC TUBING	PTZ	PAN/TILT/ZOOM
EPO	EMERGENCY POWER OFF	QTY	QUANTITY
EQUIP	EQUIPMENT	R	REMOVE
EX	EXISTING	RCP	REFLECTED CEILING PLAN
F	FURNITURE MOUNTED	RMC	RIGID METAL CONDUIT
FA	FIRE ALARM	RNC	RIGID NONMETAL CONDUIT
FCP	FIRE ALARM CONTROL PANEL	RPM	REVOLUTIONS PER MINUTE
FLA	FULL LOAD AMPS	RR	REMOVE AND RELOCATE
FMC	FLEXIBLE METAL CONDUIT	S/S	START/STOP
FOB	FREIGHT ON BOARD	SCA	SHORT CIRCUIT AMPS
FVNR	FULL VOLTAGE NON-REVERSING	SCBA	STANDARD COLOR AS SELECTED BY ARCHITECT
FVR	FULL VOLTAGE REVERSING	SF	SQUARE FOOT (FEET)
G	GROUND	SFBA	STANDARD FINISH AS SELECTED BY ARCHITECT
GEN	GENERATOR	SPDT	SINGLE POLE, DOUBLE THROW
GFCI	GROUND FAULT INTERRUPTER	SPEC	SPECIFICATION
GFP	GROUND FAULT PROTECTION	SPST	SINGLE POLE, SINGLE THROW
HD	HEAVY DUTY	ST	SINGLE THROW
HID	HIGH INTENSITY DISCHARGE	SWBD	SWITCHBOARD
HOA	HAND-OFF-AUTOMATIC	SWGR	SWITCHGEAR
HP	HORSE POWER	TL	TWIST LOCK
HPF	HIGH POWER FACTOR	TP	TELEPHONE POLE
HPS	HIGH PRESSURE SODIUM	TP	TWISTED PAIR
HV	HIGH VOLTAGE	TTB	TELEPHONE TERMINAL BOARD
HZ	HERTZ	TV	TELEVISION
		TVSS	TRANSIENT VOLTAGE SURGE SUPPRESSER
		TYP	TYPICAL
		UF	UNDERFLOOR
		UGND	UNDERGROUND
		UPS	UNINTERRUPTIBLE POWER SUPPLY
		V	VOLTS
		VA	VOLT AMPERE
		VFC/VF	VARIABLE FREQUENCY
		D	MOTOR CONTROLLER
		W	WITH
		W/O	WITHOUT
		WP	WEATHERPROOF
		XFMR	TRANSFORMER

DEFINITIONS

NOTE: ALL DEFINITIONS MAY NOT BE USED.

INDICATED: THE TERM "INDICATED" REFERS TO GRAPHIC REPRESENTATIONS, NOTES, OR SCHEDULES ON THE DRAWINGS, OTHER PARAGRAPHS OR SCHEDULES IN THE SPECIFICATIONS, AND SIMILAR REQUIREMENTS IN THE CONTRACT DOCUMENTS. WHERE TERMS SUCH AS "SHOWN", "NOTED", "SCHEDULED", AND "SPECIFIED" ARE USED, IT IS TO HELP THE READER LOCATE THE REFERENCE, NO LIMITATION ON LOCATION IS INTENDED.

DIRECTED: TERMS SUCH AS "DIRECTED", "REQUESTED", "AUTHORIZED", "SELECTED", "APPROVED", "REQUIRED", AND "PERMITTED" MEAN "DIRECTED BY THE ENGINEER", "REQUESTED BY THE ENGINEER", AND SIMILAR PHRASES.

APPROVED: THE TERM "APPROVED", WHERE USED IN CONJUNCTION WITH THE ENGINEER'S ACTION ON THE CONTRACTOR'S SUBMITTALS, APPLICATIONS, AND REQUESTS, IS LIMITED TO THE ENGINEER'S DUTIES AND RESPONSIBILITIES AS STATED IN GENERAL AND SUPPLEMENTARY CONDITIONS.

FURNISH: THE TERM "FURNISH" IS USED TO MEAN "SUPPLY AND DELIVER TO THE PROJECT SITE, READY FOR UNLOADING, UNPACKING, ASSEMBLY, INSTALLATION, AND SIMILAR OPERATIONS."

INSTALL: THE TERM "INSTALL" IS USED TO DESCRIBE OPERATIONS AT PROJECT SITE INCLUDING THE ACTUAL "UNLOADING, UNPACKING, ASSEMBLY, ERECTION, PLACING, ANCHORING, APPLYING, WORKING TO DIMENSION, FINISHING, CURING, PROTECTING, CLEANING, AND SIMILAR OPERATIONS."

PROVIDE: THE TERM "PROVIDE" MEANS "TO FURNISH AND INSTALL, COMPLETE AND READY FOR THE INTENDED USE."

INSTALLER: AN "INSTALLER" IS THE CONTRACTOR OR AN ENTITY ENGAGED BY THE CONTRACTOR, EITHER AS AN EMPLOYEE, SUBCONTRACTOR, OR SUB-SUBCONTRACTOR, FOR PERFORMANCE OF A PARTICULAR CONSTRUCTION ACTIVITY, INCLUDING INSTALLATION, ERECTION, APPLICATION, AND SIMILAR OPERATIONS. INSTALLERS ARE REQUIRED TO BE EXPERIENCED IN THE OPERATIONS THEY ARE ENGAGED TO PERFORM.


TECHNOLOGY SYSTEMS: THE TERM "TECHNOLOGY SYSTEMS" IS USED TO DESCRIBE ALL LOW VOLTAGE SYSTEMS GENERALLY REFERRED TO AS "SPECIAL SYSTEMS". THESE SYSTEMS INCLUDE BUT ARE NOT NECESSARILY LIMITED TO ALL SYSTEMS WHICH UTILIZE VOLTAGES OF LESS THAN 71 VOLTS SUCH AS SOUND SYSTEMS, VIDEO SYSTEMS, TV SYSTEMS, SECURITY SYSTEMS, VOICE AND DATA CABLING SYSTEMS, ETC. ...

GENERAL ELECTRICAL NOTES

- CLARIFICATION METHODS: AT THE TIME OF BIDDING, BIDDERS SHALL FAMILIARIZE THEMSELVES WITH THE DRAWINGS AND SPECIFICATIONS. ANY QUESTIONS, MISUNDERSTANDINGS, CONFLICTS, DELETIONS, DISCONTINUED PRODUCTS, CATALOG NUMBER DISCREPANCIES, DISCREPANCIES BETWEEN THE EQUIPMENT SUPPLIED AND THE INTENT OR FUNCTION OF THE EQUIPMENT, ETC. SHALL BE SUBMITTED TO THE ARCHITECT/ENGINEER IN WRITING FOR CLARIFICATION PRIOR TO ISSUANCE OF THE FINAL ADDENDUM AND BIDDING OF THE PROJECT. WHERE DISCREPANCIES OR MULTIPLE INTERPRETATIONS OCCUR, THE MOST STRINGENT (WHICH IS GENERALLY RECOGNIZED AS THE MOST COSTLY) THAT MEETS THE INTENT OF THE DOCUMENTS SHALL BE ENFORCED.
- OWNER FURNISHED ITEMS: THE OWNER WILL FURNISH MATERIAL AND EQUIPMENT AS INDICATED IN THE CONTRACT DOCUMENTS TO BE INCORPORATED INTO THE WORK. THESE ITEMS ARE ASSIGNED TO THE INSTALLER AND COSTS FOR RECEIVING, HANDLING, STORAGE, IF REQUIRED, AND INSTALLATION ARE INCLUDED IN THE CONTRACT SUM.
 - THE INSTALLER'S RESPONSIBILITIES ARE THE SAME AS IF THE INSTALLER FURNISHED THE MATERIALS OR EQUIPMENT.
 - THE OWNER WILL ARRANGE AND PAY FOR DELIVERY OF OWNER FURNISHED ITEMS FREIGHT ON BOARD JOB SITE AND THE INSTALLER WILL INSPECT DELIVERIES FOR DAMAGE. IF OWNER FURNISHED ITEMS ARE DAMAGED, DEFECTIVE OR MISSING, DOCUMENT DAMAGED ITEMS WITH THE TRANSPORT COMPANY AND THE OWNER WILL ARRANGE FOR REPLACEMENT. THE OWNER WILL ALSO ARRANGE FOR MANUFACTURER'S FIELD SERVICES, AND THE DELIVERY OF MANUFACTURER'S WARRANTIES AND BONDS TO THE INSTALLER.
 - THE INSTALLER IS RESPONSIBLE FOR DESIGNATING THE DELIVERY DATES OF OWNER FURNISHED ITEMS AND FOR RECEIVING, UNLOADING AND HANDLING OWNER FURNISHED ITEMS AT THE SITE. THE INSTALLER IS RESPONSIBLE FOR PROTECTING OWNER FURNISHED ITEMS FROM DAMAGE, INCLUDING DAMAGE FROM EXPOSURE TO THE ELEMENTS, AND TO REPAIR OR REPLACE ITEMS DAMAGED AS A RESULT OF HIS OPERATIONS.
- EXPOSED STRUCTURE AREAS (EXCLUDING MECHANICAL, ELECTRICAL, AND COMMUNICATION SPACES): INSTALL RACEWAYS BETWEEN DECK AND STRUCTURE WHEREVER POSSIBLE IN EXPOSED STRUCTURE CEILING AREAS. ROUTE RACEWAYS IN CONCEALED AREAS WHEREVER POSSIBLE. REFER ALL CONDITIONS WHERE RACEWAYS MUST BE INSTALLED WHICH CANNOT COMPLY WITH THESE REQUIREMENTS TO THE ARCHITECT.
- SUBMITTALS: PROVIDE ORIGINAL ELECTRONIC PDF FORMAT, BOUND, BOOKMARKED (EACH SECTION AND PRODUCT), AND HIGHLIGHTED. JOB NAME AND SUBCONTRACTOR SHALL BE ON THE FRONT COVER. PREPARE INDEX OF EQUIPMENT SUBMITTED IN EACH TAB.
- REFLECTED CEILING PLANS: COORDINATE THE LOCATION OF LIGHT FIXTURES WITH THE ARCHITECTURAL REFLECTED CEILING PLANS. REFER ALL DISCREPANCIES TO THE ARCHITECT AND ENGINEER.
- ALL WORK SHALL BE DONE ACCORDING TO THE CURRENT NATIONAL ELECTRIC CODE (NEC), IBC, NFPA, AND IFC. COMPLIANCE AND FINAL APPROVAL IS SUBJECT TO THE ON SITE FIELD INSPECTION OF THE AHJ.
- TAKE OFF QUANTITIES SHOWN IN SCHEDULE(S) ARE FOR REFERENCE ONLY. THE CONTRACTOR IS RESPONSIBLE TO PROVIDE ALL OF THE DEVICES, FIXTURES, EQUIPMENT, RACEWAYS, CONDUCTORS, CABLING, ETC. SHOWN AND SPECIFIED IN THE CONTRACT DOCUMENTS INCLUDING THE EXTRA MATERIAL SPECIFIED.

ELECTRICAL SHEET INDEX

EE001	ELEC COVER SHEET
ES101	ELECTRICAL SITE PLAN
ES505	SITE JUNCTION BOX DETAILS
ES508	ELECTRICAL SITE LIGHTING DETAILS AND SCHEDULES
ES601	ONE-LINE DIAGRAM
ES602	EXTERIOR LIGHTING FIXTURE SCHEDULE

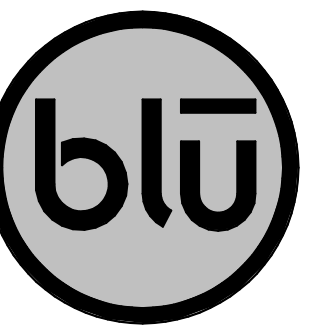

blu line designs
 planning | landscape architecture | design
 8719 S. Sandy Parkway
 Sandy, UT 84070
 p 801.679.3157

OWNER:
 LAYTON CITY
 437 N WASHATCH DR.
 LAYTON, UT 84041


CONTACT:
 JOELEEN GRANDY
 PH: 801-336-3926

WELKER TRAILHEAD IMPROVEMENTS

2700 NORTH 2125 EAST
 LAYTON, UT 84041

REVISIONS

NO.	DATE	DESCRIPTION

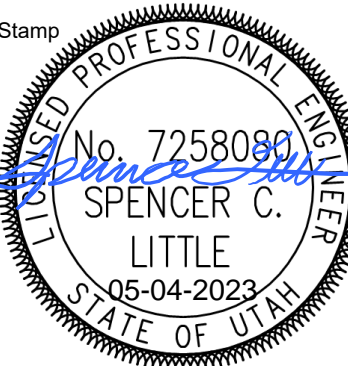

Designed By: JUN
 Drawn By: JUN
 Date: 04/26/2023
 Checked By: SCL
 Project No: 230019

Drawing Title


ELEC COVER SHEET

Drawing number

EE001

NOTE TO CONTRACTORS:
 THIS SHEET SET IS CONTRACTUALLY REQUIRED TO BE PRINTED IN COLOR. THERE ARE DIFFERENTIATING FEATURES THAT ARE DESIGNATED THROUGHOUT BY THEIR COLOR. FAILURE TO PRINT THIS SHEET SET IN COLOR MAY RESULT IN A MISINTERPRETATION OF THE DRAWINGS.

BID SET

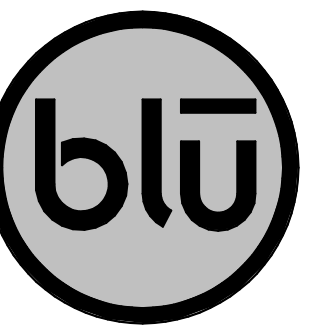

blu line designs
planning | landscape architecture | design

8719 S. Sandy Parkway
Sandy, UT 84070
p 801.679.3157

OWNER:
LAYTON CITY
437 N WASATCH DR.
LAYTON, UT 84041

CONTACT:
JOELLEN GRANDY
PH: 801-336-3926

GENERAL SHEET NOTES



- 1 THE ELECTRICAL CONTRACTOR SHALL MEET WITH AND COORDINATE WITH ALL SERVICE PROVIDERS (POWER, COMMUNICATION, CABLE/SATELLITE, ETC.) TO THE FACILITY ON SITE PRIOR TO ANY WORK BEING PERFORMED. CONFIRM WITH EACH SERVICE PROVIDER EXACT LOCATIONS EQUIPMENT AND ROUTING. COMPLY WITH ALL SERVICE PROVIDER'S CURRENT STANDARDS AND REQUIREMENTS. PROVIDE THE REQUIRED EQUIPMENT, RACEWAYS, BOXES, CABLE, ETC. AS REQUIRED BY THE SERVICE PROVIDER WEATHER SHOWN ON THE DRAWINGS OR NOT.
- 2 FOR ALL LIGHT FIXTURES, POLE LIGHTS, AND ALL OTHER ELECTRICAL DEVICES THE CONTRACTOR SHALL COORDINATE EXACT LOCATION AND MOUNTING HEIGHTS WITH ARCHITECT, OWNER, ENGINEER, AND ALL OF THE CONTRACT DOCUMENTS PRIOR TO ROUGH IN AND TRENCHING.
- 3 CONTRACTOR IS RESPONSIBLE FOR ALL TRENCHING, BACKFILL, AND COMPACTION ASSOCIATED TO ALL ELECTRICAL UNDERGROUND RACEWAYS AND CABLES. COORDINATE WITH ARCHITECTURAL AND CIVIL DRAWINGS. SEE UNDERGROUND RACEWAY DETAILS FOR REQUIREMENTS FOR EACH TRENCH.
- 4 CONTRACTOR SHALL INSTALL POLE MOUNTED LIGHTS IN STRAIGHT LINES, SQUARE, AND PLUMB. COORDINATE WITH ARCHITECT AND CIVIL DRAWINGS.
- 5 THE ELECTRICAL CONTRACTOR SHALL HAVE ANY AND ALL CONCRETE POLE BASES AND SLABS REVIEWED BY A STRUCTURAL ENGINEER AND SHALL MODIFY DESIGN PER STRUCTURAL ENGINEER'S AND OR AHJ'S RECOMMENDATIONS.
- 6 THE ELECTRICAL CONTRACTOR IS RESPONSIBLE FOR ALL CONCRETE/ASPHALT CUTTING AND REPLACEMENT OF CONCRETE/ASPHALT TO MATCH EXISTING ASSOCIATED WITH UNDERGROUND RACEWAYS PROVIDED AS PART OF THIS PROJECT.
- 7 REFER TO PLANS FOR CONSTRAINTS ON PHYSICAL DIMENSIONS AND CLEARANCE REQUIREMENTS OF EQUIPMENT. PROVIDE EQUIPMENT DIMENSIONS THAT FALL WITHIN THE CONSTRAINTS OF EACH SPECIFIC LOCATION.
- 8 PROVIDE SERVICE RATED EQUIPMENT AT EACH SERVICE ENTRANCE.
- 9 SERVICE EQUIPMENT SHALL BE LEGIBLY MARKED IN THE FIELD WITH THE MAXIMUM AVAILABLE FAULT CURRENT. VERIFY OR RE-CALCULATE THE AVAILABLE FAULT CURRENT AT THE SERVICE WHERE MODIFICATIONS TO THE ELECTRICAL INSTALLATION OCCUR. PLEASE INCLUDE NOTES IN THE ELECTRICAL DRAWINGS OR SUPPLY CALCULATIONS WHERE APPLICABLE. SEE NEC 110.24. (B)

SHEET KEYNOTES

- 1 PROVIDE 1.5" CONDUIT FOR TELECOMMUNICATION LINES TO FUTURE SECURITY CAMERAS. RUN CONDUIT TO NEW RESTROOM AND STUB UP INTO CHASE OF RESTROOM.
- 2 PROVIDE 1.5" CND FOR UTOPIA SECURITY CAMERA FROM CHASE IN NEW RESTROOM. CONDUIT TO STUB UP INTO LIGHT POLE. COORDINATE EXACT REQUIREMENTS FOR STUB UP LOCATION AND ACCESS PANEL AVAILABILITY PRIOR TO ROUGH-IN.
- 3 METER TO BE INSTALLED ON OUTSIDE WALL OF NEW RESTROOM. COORDINATE EXACT LOCATION WITH ARCHITECT PRIOR TO ROUGH-IN.
- 4 LIGHT FIXTURE TO BE NEW EXPERIMENTAL SOLAR OPTION. PRODUCT TO BE FONROCHE AUTONOMOUS LIGHTING FIXTURES. LIGHT FIXTURE TO BE MOUNTED ON 20' LIGHT POLE, AND TO BE PROGRAMMED TO OPERATE AT FULL LIGHT FOR (5) HOURS AFTER SUNSET. THEN DIMMING FOR THE REMAINDER OF THE NIGHT. THEN AT FULL LIGHT FOR AN HOUR BEFORE SUNRISE. COORDINATE EXACT LIGHTING REQUIREMENTS WITH THE LIGHTING PROVIDER PRIOR TO ROUGH-IN.
- 5 PANEL TO BE INSTALLED IN NEW RESTROOM CHASE. COORDINATE EXACT LOCATION WITH ARCHITECT PRIOR TO ROUGH-IN.
- 6 APPROXIMATE LOCATION OF EXISTING UTILITY TRANSFORMER. CONDUIT TO STUB UP INTO TRANSFORMER WHERE FEEDER IS TO CONNECT. CONTRACTOR TO FIELD VERIFY EXACT LOCATION, CONNECTION MEANS, AND ALL INSTALLATION REQUIREMENTS OF CONDUIT WITH UTILITY PROVIDER PRIOR TO ROUGH-IN.
- 7 SECONDARY BOX BY UTILITY PROVIDER. CONTRACTOR TO COORDINATE EXACT LOCATION, CONNECTION, AND INSTALLATION SCOPE WITH UTILITY PROVIDER PRIOR TO ROUGH-IN.

WIRING LEGEND

	12AWG WIRE SIZE TYPICAL
	14AWG WIRE SIZE TYPICAL
	SWITCHED LEG FOR LTG CKT WIRE SIZE BY BRANCH CIRCUIT
	VOICE/DATA CABLE CAT6 TYPICAL
	WIRE SIZE SPECIFIED BY CALLOUT TAG
	CONDUCTOR & CONDUIT INDICATOR REFER TO EQUIPMENT SCHEDULE OF ASSOCIATED EQUIPMENT/DEVICE

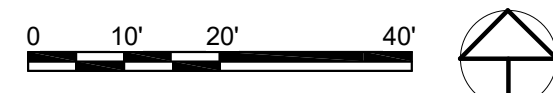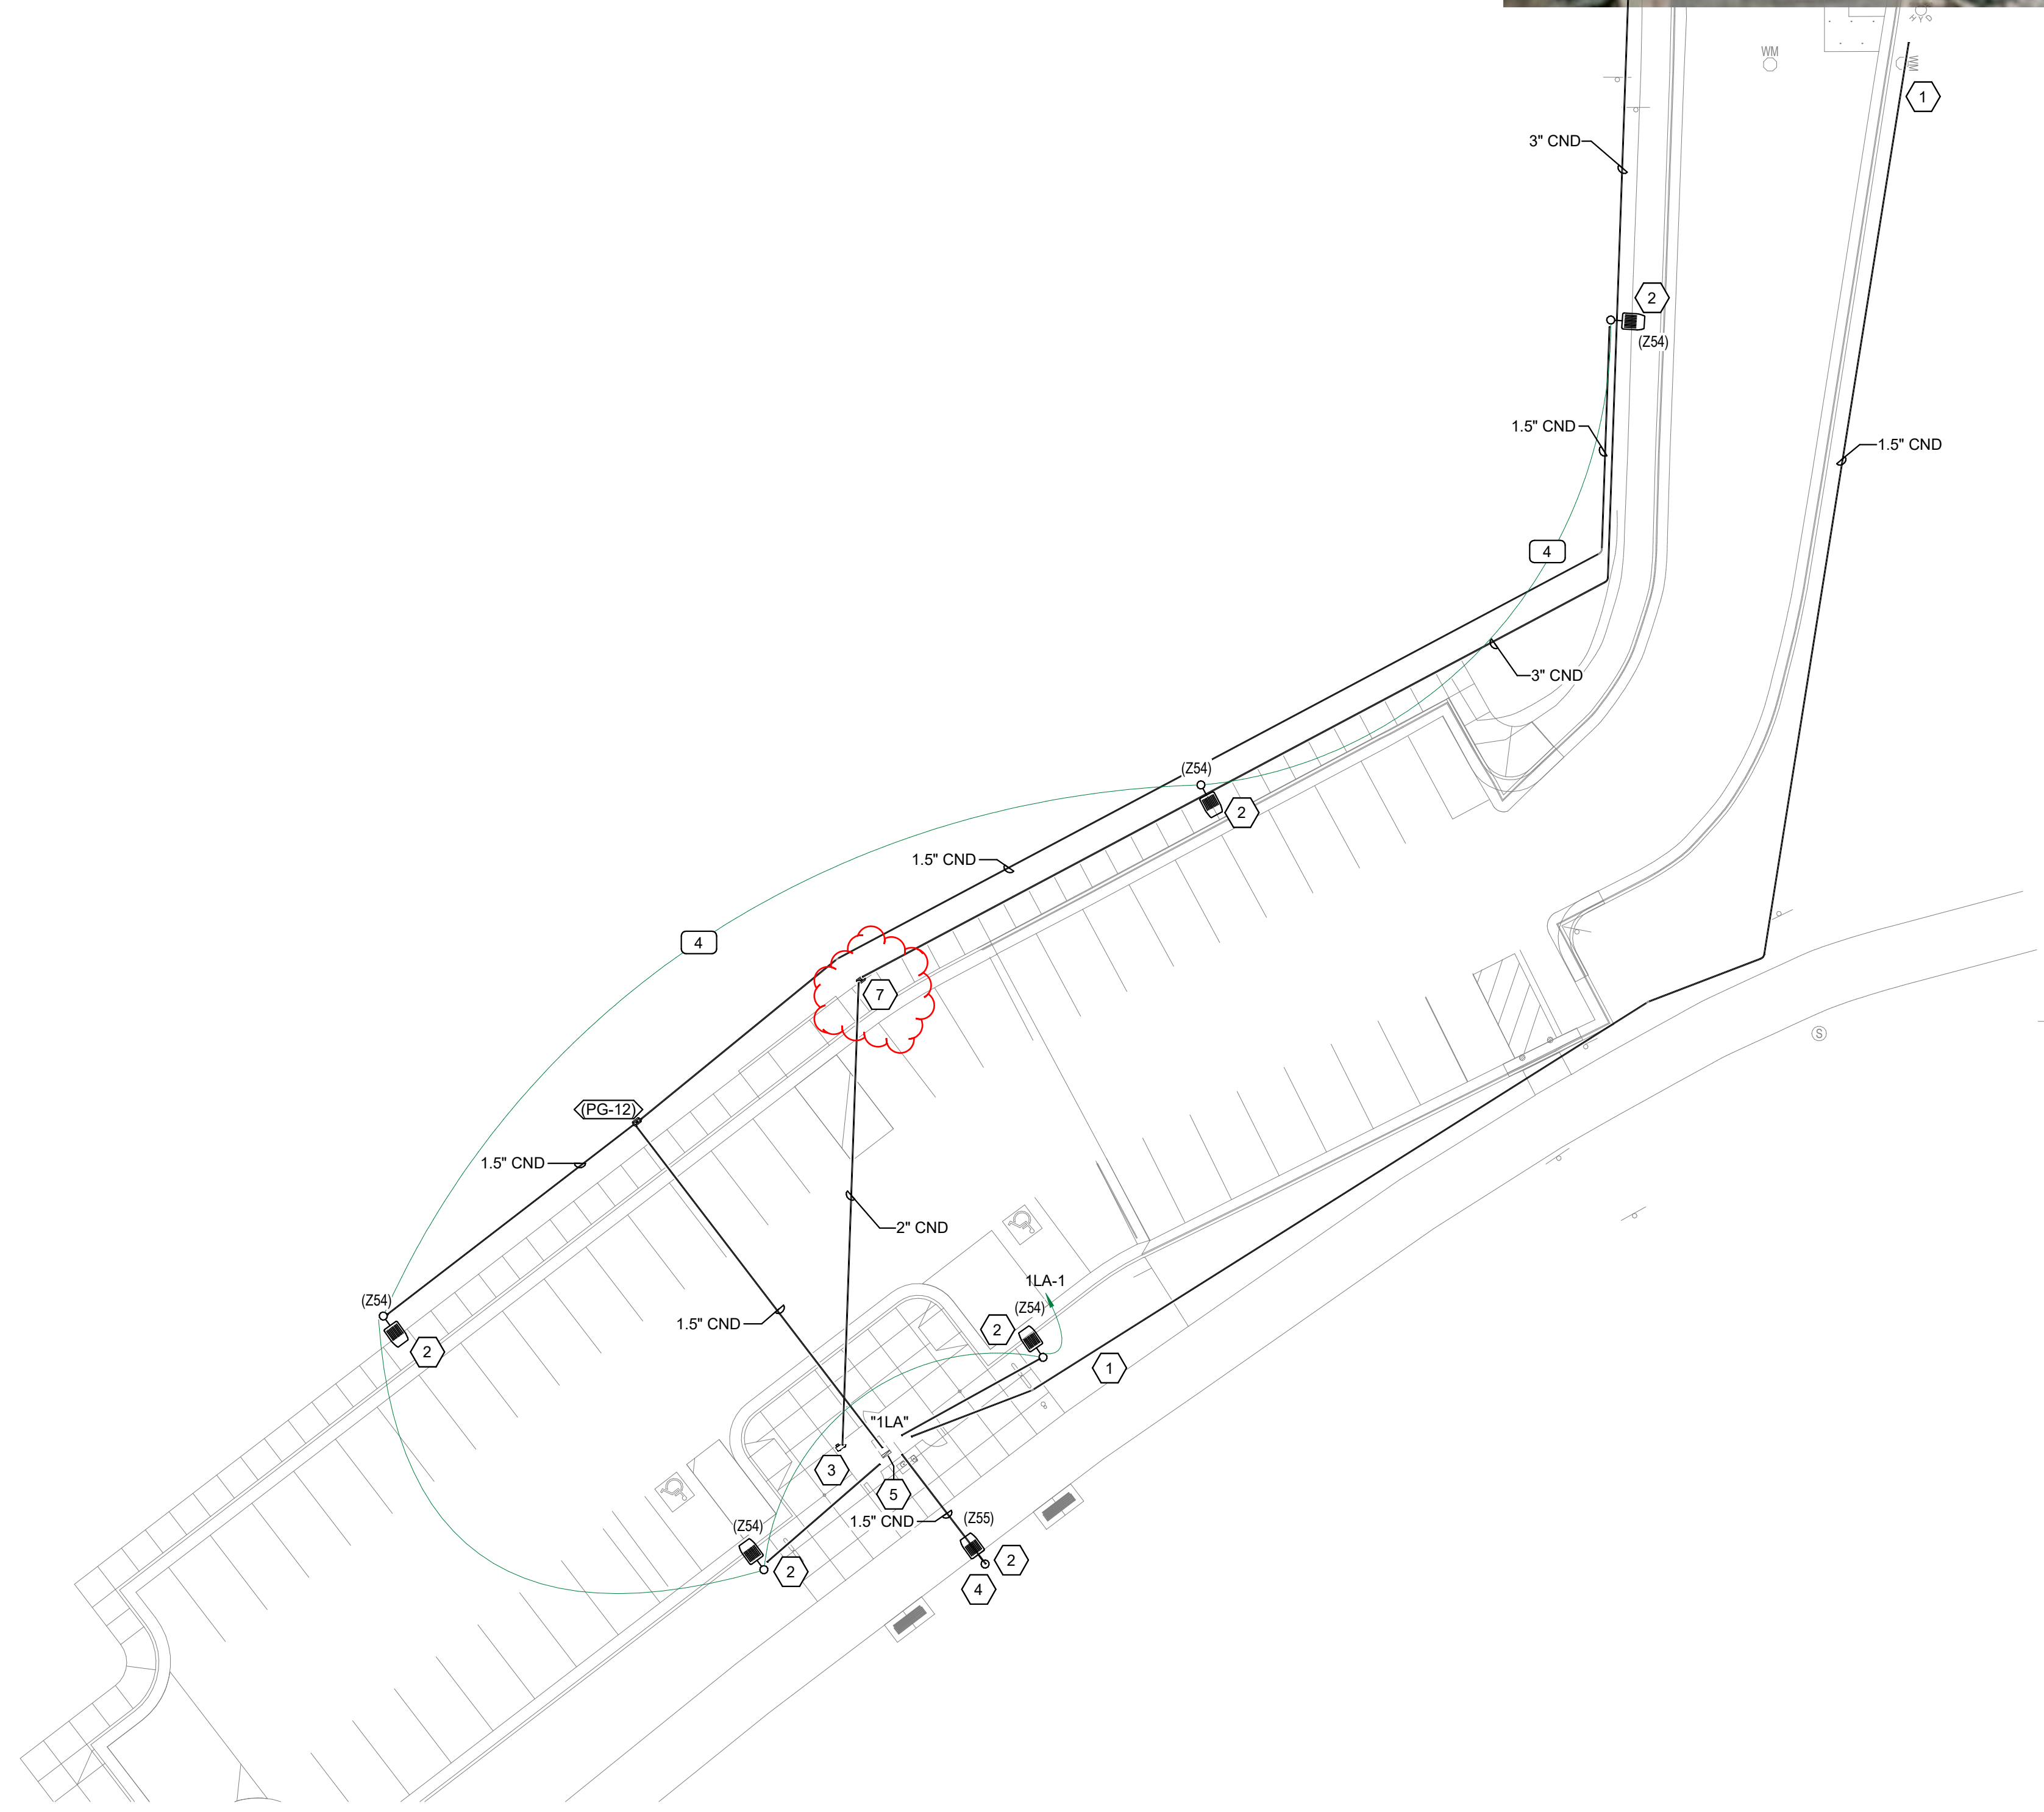


1 ELECTRICAL SITE PLAN

SCALE: 1" = 20'-0"

WELKER TRAILHEAD IMPROVEMENTS

2700 NORTH 2125 EAST
LAYTON, UT 84041

NO.	DATE	DESCRIPTION

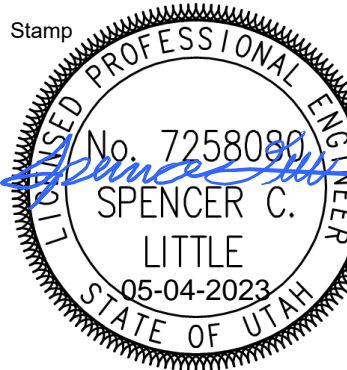


Designed By: JUN
Drawn By: JUN
Date: 04/26/2023
Checked By: SCL
Project No: 230019

Drawing Title
**ELECTRICAL
SITE PLAN**

Drawing number
ES101

BID SET

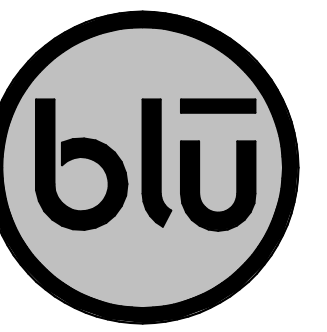

blu line designs
 planning | landscape architecture | design
 8719 S. Sandy Parkway
 Sandy, UT 84070
 p 801.679.3157

OWNER:
 LAYTON CITY
 437 N WASATCH DR.
 LAYTON, UT 84041


CONTACT:
 JOELLEN GRANDY
 PH: 801-336-3926

WELKER TRAILHEAD IMPROVEMENTS

2700 NORTH 2125 EAST
 LAYTON, UT 84041

REVISIONS

NO.	DESCRIPTION

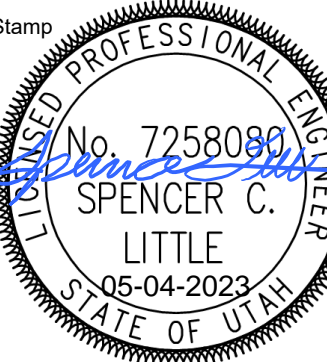


Designed By: JUN
 Drawn By: JUN
 Date: 04/26/2023
 Checked By: SCL
 Project No: 230019

Drawing Title
SITE ELECTRICAL DETAILS

Drawing number


ES502

Not applicable to plan set. Panels are to be installed inside the chase of the restroom. Meter to be installed on the outside of the restroom.

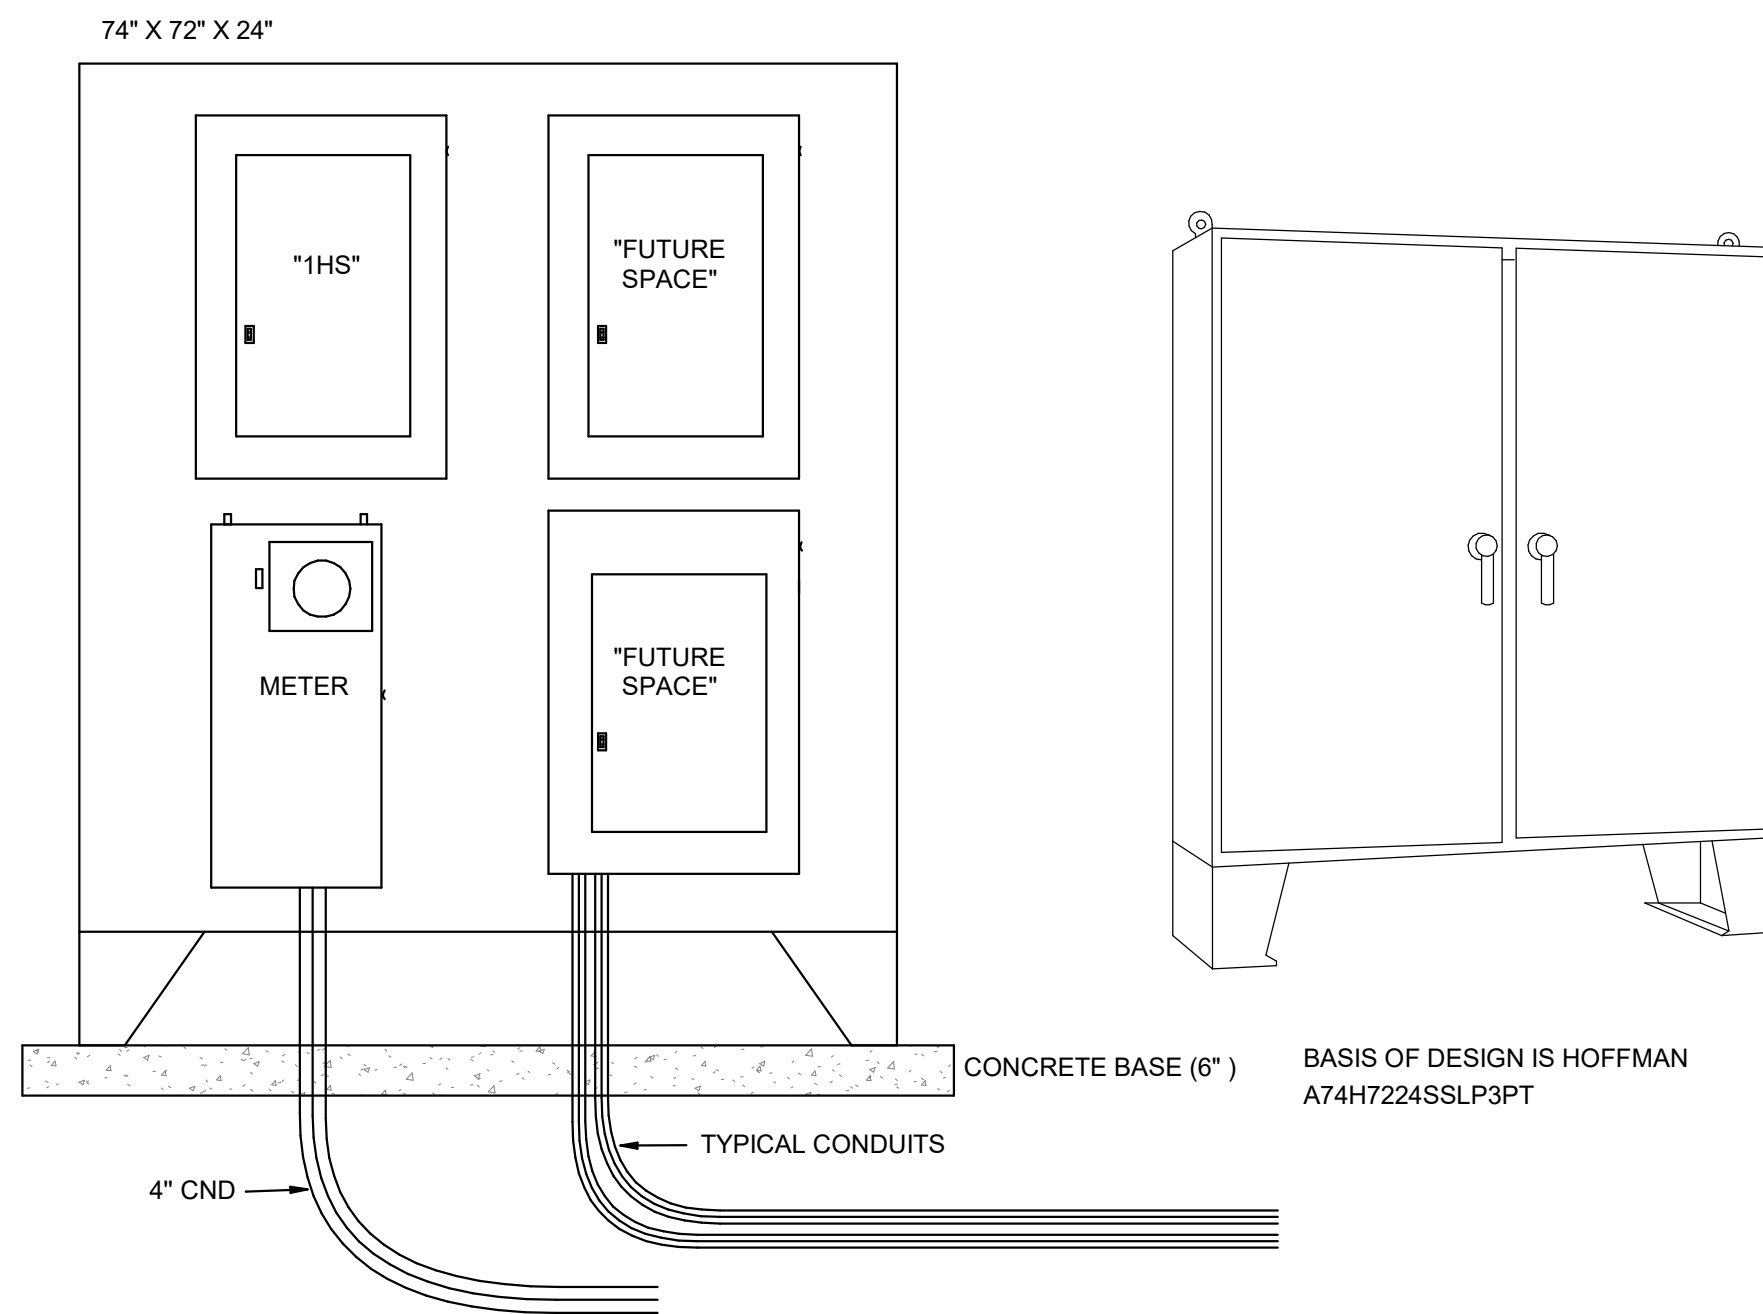


- GENERAL NOTES:
 1. PROVIDE NEMA 4X STAINLESS STEEL ENCLOSURE.
 2. ELECTRICAL CONTRACTOR MUST CONFIRM ENCLOSURE WITH ELECTRICAL ENGINEER BEFORE INSTALLATION.

B3 FREESTANDING STRONG BOX WITH PANEL AND GEAR DETAIL
 SCALE: NTS

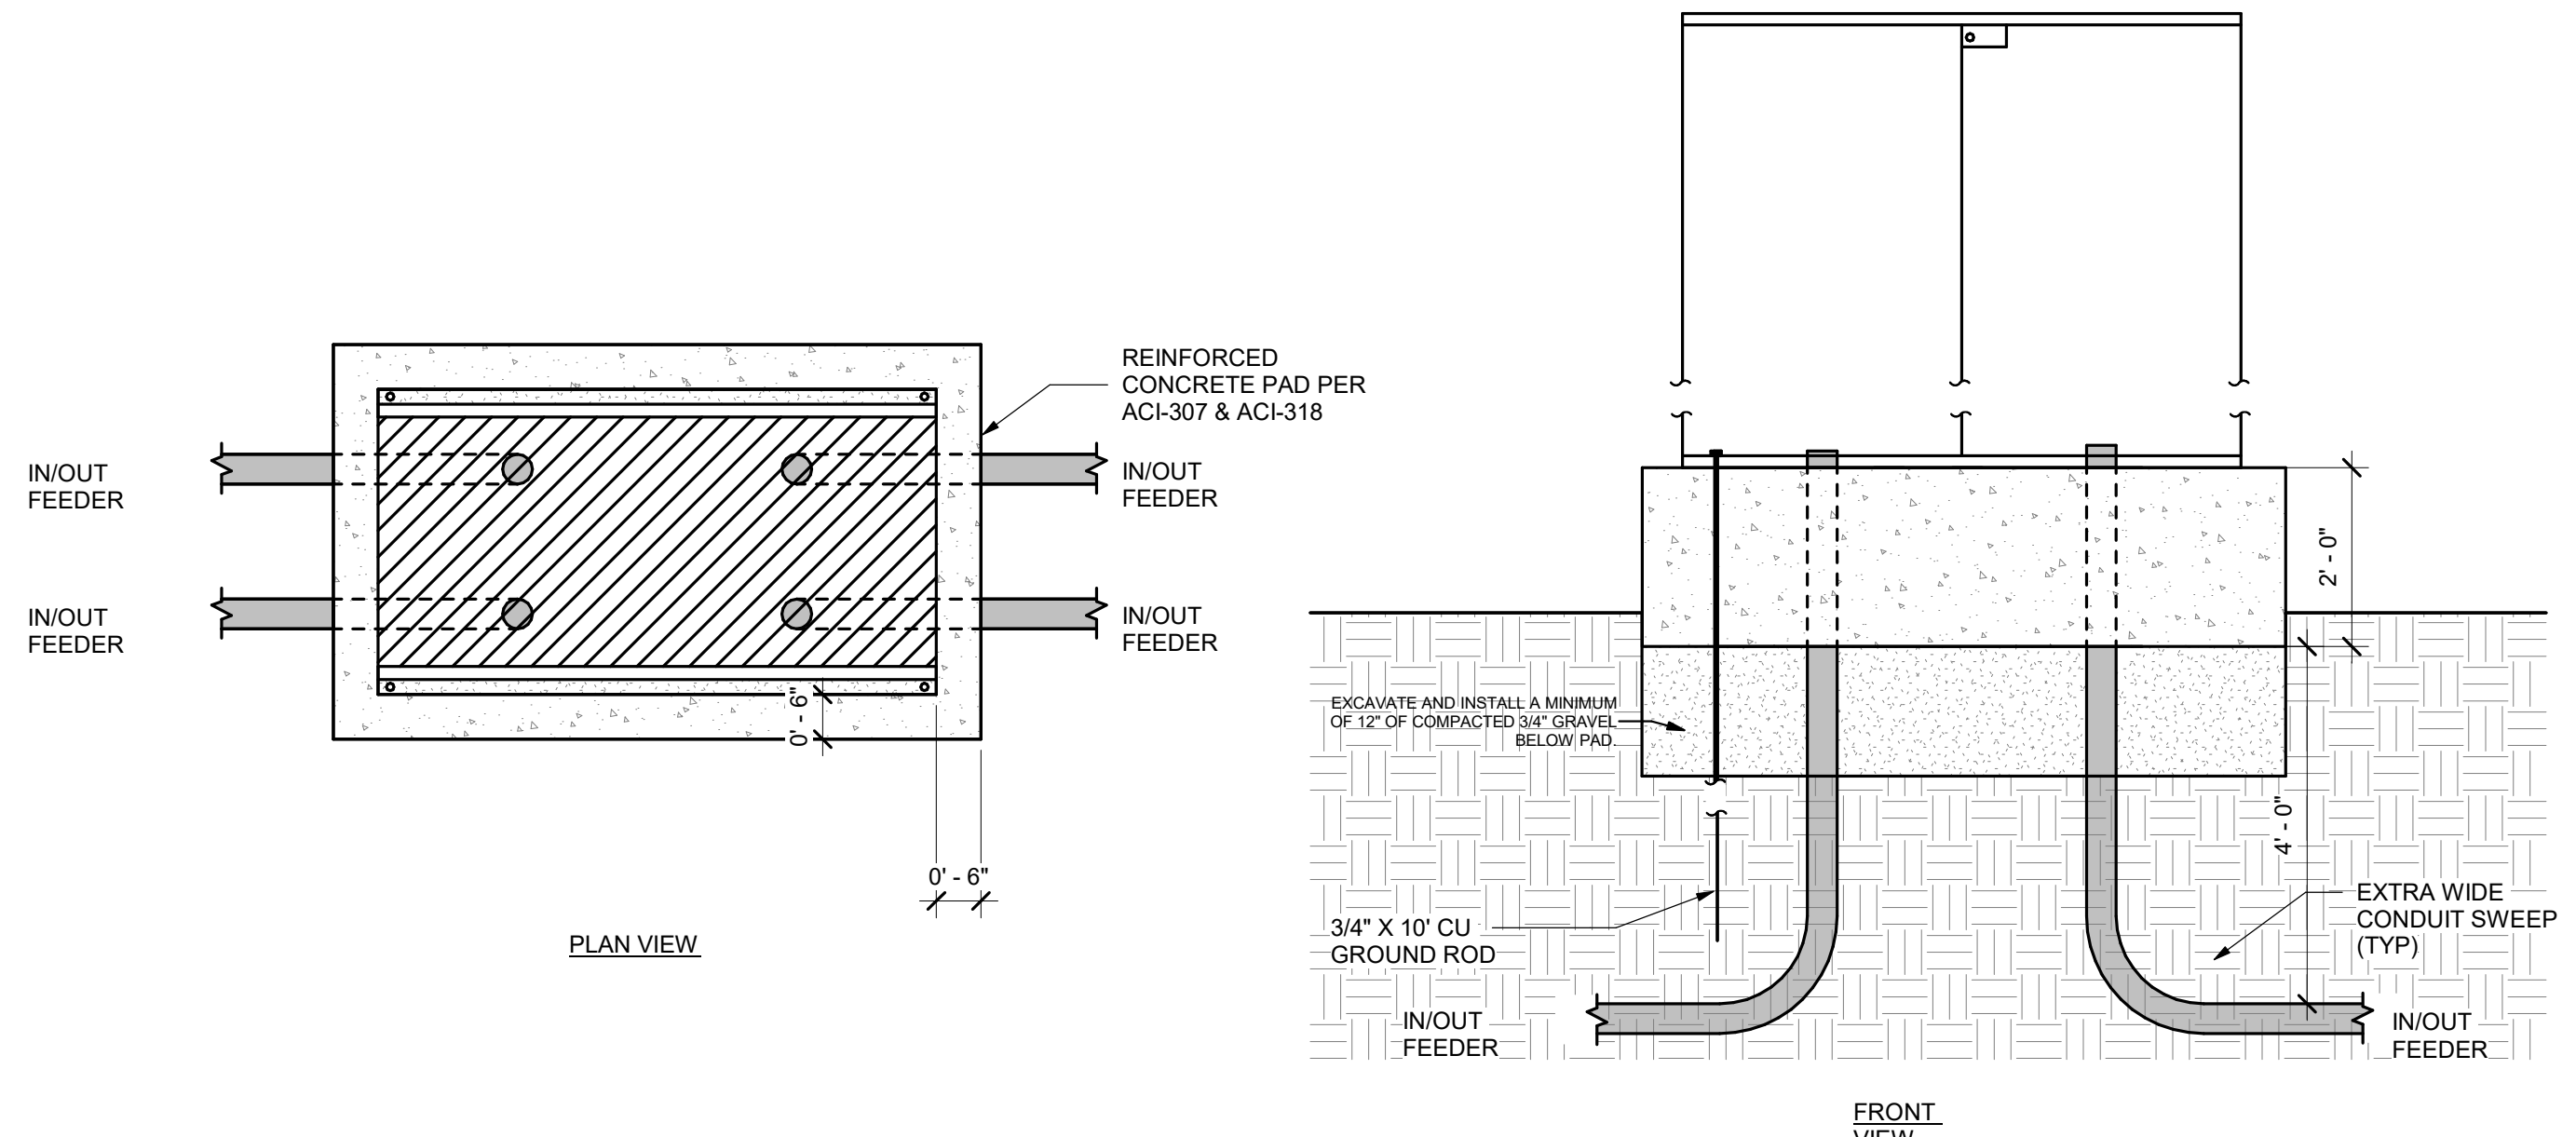

A3 TYPICAL CONCRETE BASE FOR MOUNTED STRONG BOX DETAIL
 SCALE: NTS

BID SET

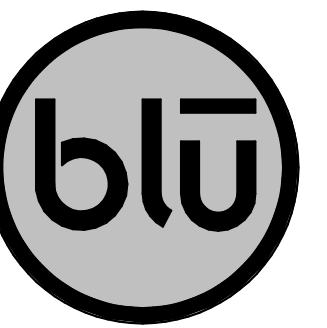

blu line designs
planning | landscape architecture | design

8710 S. Sandy Parkway
Sandy, UT 84070
p 801.679.3157

OWNER:
LAYTON CITY
437 N WASATCH DR.
LAYTON, UT 84041




CONTACT:
JOELLEN GRANDY
PH: 801-336-3926

APPLICATION TIERS	TYPE	DESCRIPTION	BOX OPTIONS	DESCRIPTION	COVER OPTIONS	DESCRIPTION	SYMBOLS LEGEND				FIXTURE STYLES		
LIGHT DUTY	VERTICAL	PEDESTRIAN TRAFFIC ONLY.	BA	BOX WITH OPEN BOTTOM	CA	BOLT DOWN COVER	PG-34	PG-22	PG-23	PG-22	STYLE NAME	DESCRIPTION	IMAGES
TIER 5	VERTICAL	SIDEWALK APPLICATIONS WITH A SAFETY FACTOR FOR OCCASIONAL ACCIDENTAL VEHICULAR TRAFFIC.	BB	BOX WITH MOUSE HOLES	WA	STANDARD WITH NO BOLTS							
TIER 8	LATERAL		VERTICAL	BC	DIVIDED BOX	LR	CAST IRON 6 4-1/2" X 7-1/2" LID					PC	STRAIGHT SIDES ALLOW FOR EASY ADJUSTMENT OF BOX SHOULD THE GRADE LEVEL CHANGE. ALL PC BOXES ARE STACKABLE AND ARE AVAILABLE WITH GASKETING.
TIER 15	VERTICAL	DRIEVEWAY, PARKING LOT, AND OFF ROAD APPLICATIONS SUBJECT TO OCCASIONAL ACCIDENTAL VEHICULAR TRAFFIC.	BG	GASKETED BOX WITH OPEN BOTTOM	LP	CAST IRON 6"X12" LID					PX	PX STYLES ARE EXCELLENT FOR SERVICE BOX ASSEMBLIES AND OFFER FLARED DESIGN TO PREVENT FROST HEAVE. PX BOXES ARE ALSO NESTABLE FOR COMPACT STORAGE.	
TIER 22	LATERAL		LATERAL	DA	BOX WITH SOLID BOTTOM	LQ	CAST IRON 9"X12" LID						PT
	VERTICAL	DRIVEWAY, PARKING LOT, AND OFF ROAD APPLICATIONS SUBJECT TO NON-DELIBERATE HEAVY VEHICULAR TRAFFIC.	DG	GASKETED BOX WITH SOLID BOTTOM	LK	POLYMER CONCRETE 6"X9" DROP-IN LID					PD	THESE ENCLOSURES FEATURE A 1 DEGREE FLARE FOR MAXIMUM STRENGTH. FLARED DESIGN OPTIMIZES INTERNAL VOLUME AND MINIMIZES FROST HEAVE.	
	LATERAL		JA	FOOTED BOX	LL	POLYMER CONCRETE 7" X 13" DROP-IN LID							
			EA	EXTENSION	LS	THROUGH SLOT (NO METER LID)							
			RA	SOLID BASE EXTENSION	O2	OPENS UNDER 90°							
					OO	USED WITH DROP-IN LID							

NOTES:
1. CONTRACTOR SHALL PROVIDE A SUBMITTAL ON ALL UNDERGROUND ENCLOSURES FOR THIS PROJECT.
2. ALL ENCLOSURES SHALL BE UL LISTED
3. CONTRACTOR SHALL COORDINATE THE TIER RATING WITH CIVIL ENGINEER AND ARCHITECT IN THE SUBMITTAL PROCESS.
4. CONTRACTOR SHALL ADJUST THE SIZE OF THE ENCLOSURE AS REQUIRED FOR INSTALLATION. SUBMIT AN RFI OR PROVIDE SOME OTHER DOCUMENTATION SO THAT THE DESIGN TEAM AND OWNER UNDERSTAND THIS MODIFICATION PRIOR TO MOVING FORWARD WITH ADJUSTED SIZE OF ENCLOSURE.
5. PROVIDE BASIS OF DESIGN (BOD) ENCLOSURE OR PRE-APPROVED EQUAL.

UNDER GROUND ENCLOSURE SCHEDULE


ID	IMAGE	BOX DESCRIPTION	LENGTH	WIDTH	DEPTH	ABOVE GRADE HEIGHT	BASIS OF DESIGN MANUFACTURE PART NO.	BOX OPTIONS	COVER LOGO	COVER OPTIONS	STYLE	TRAFFIC TIER NO.
(PG-12)		UNDERGROUND ENCLOSURE; PRECAST POLYMER CONCRETE WITH REINFORCED WITH FIBER GLASS. PROVIDE WITH BOLT ON COVER.	0' - 11"	1' - 6"	1' - 6"	INSTALL FLUSH WITH GRADE	QUAZITE (PG1324-18)	BA - BOX WITH OPEN BOTTOM	"ELECTRICAL"	WITH TWO BOLTS AND A SINGLE LOGO	PG	TIER 15

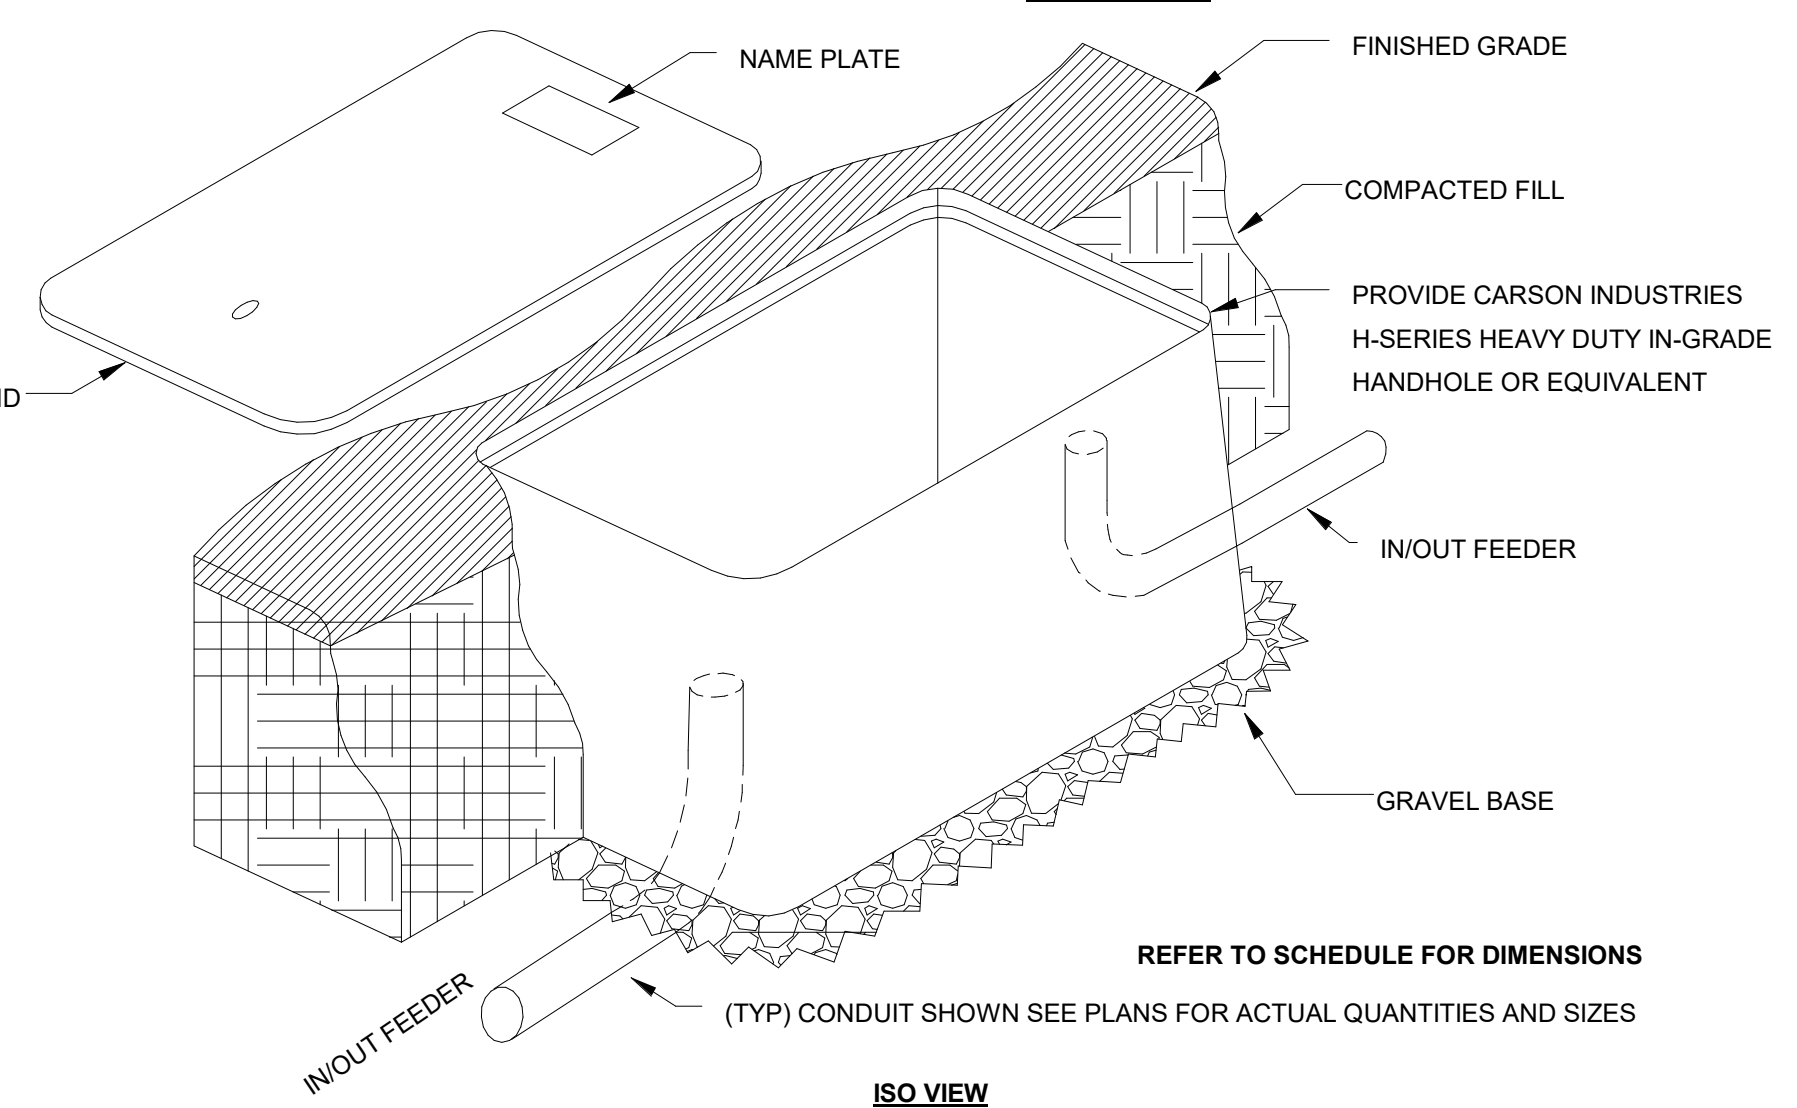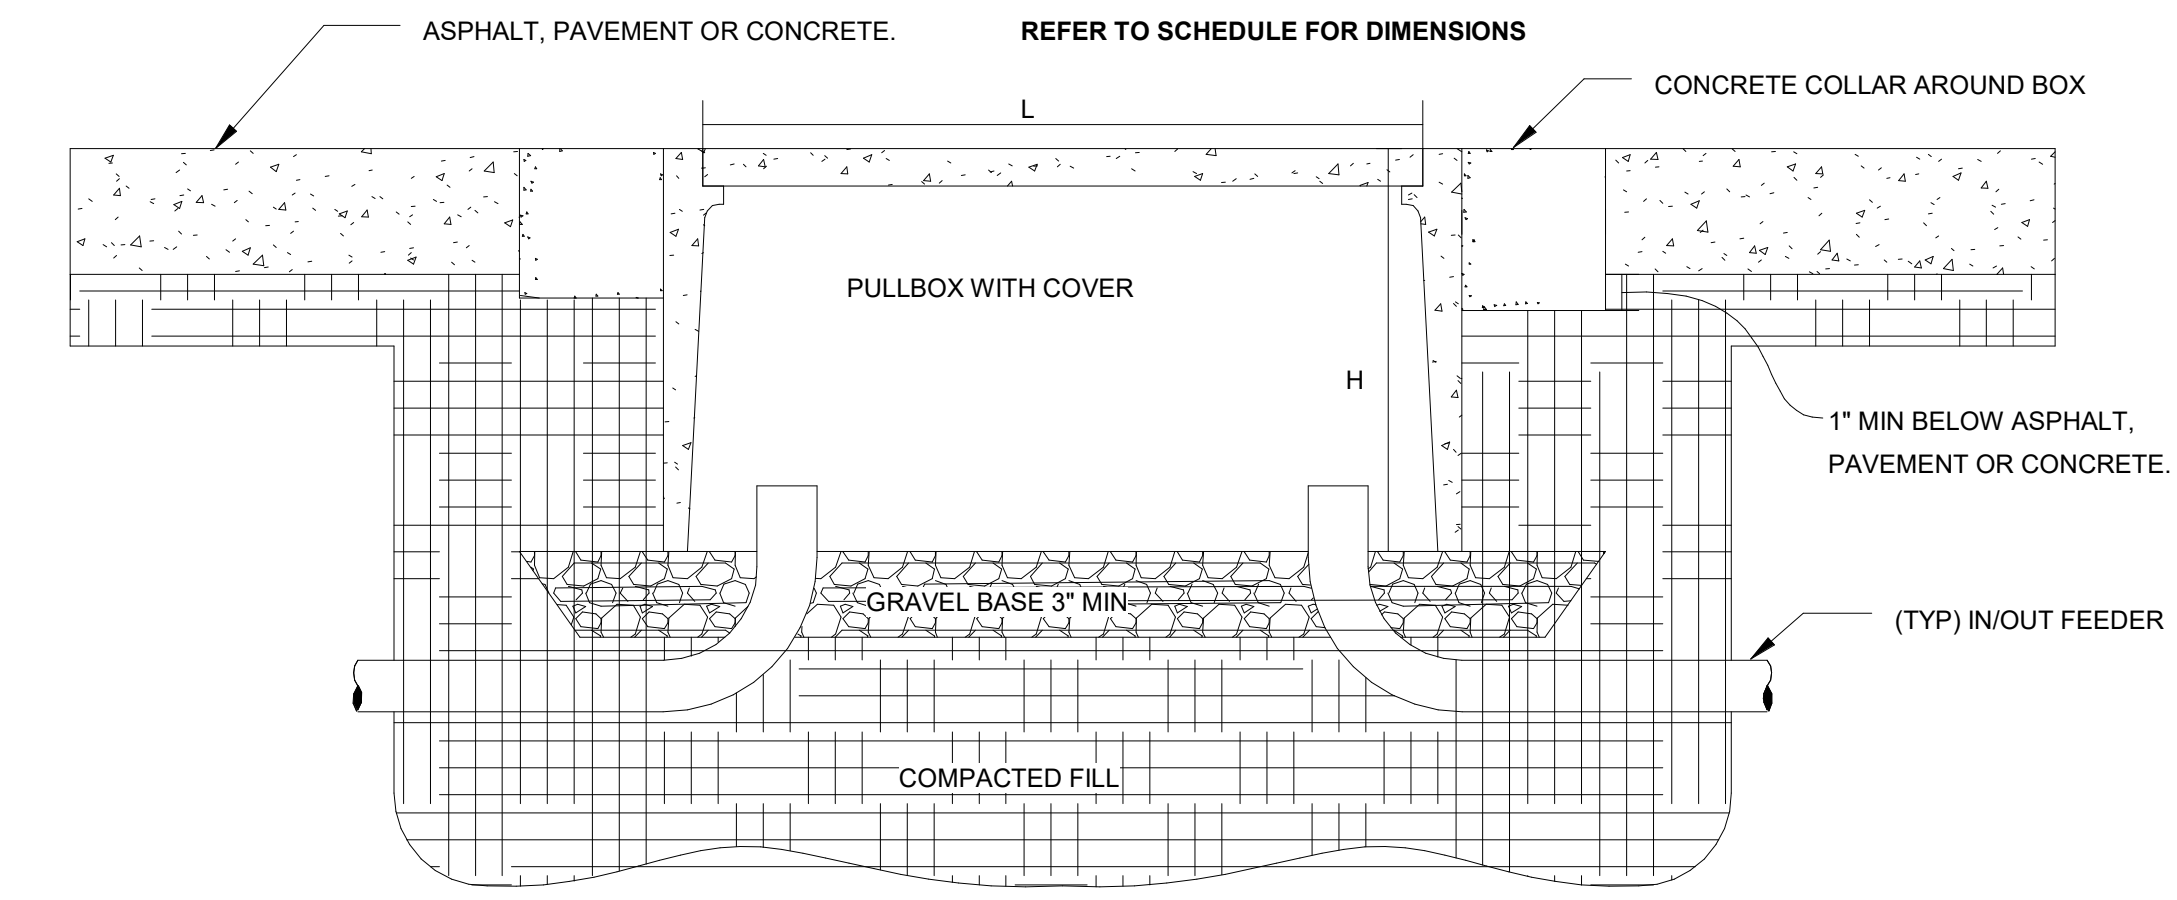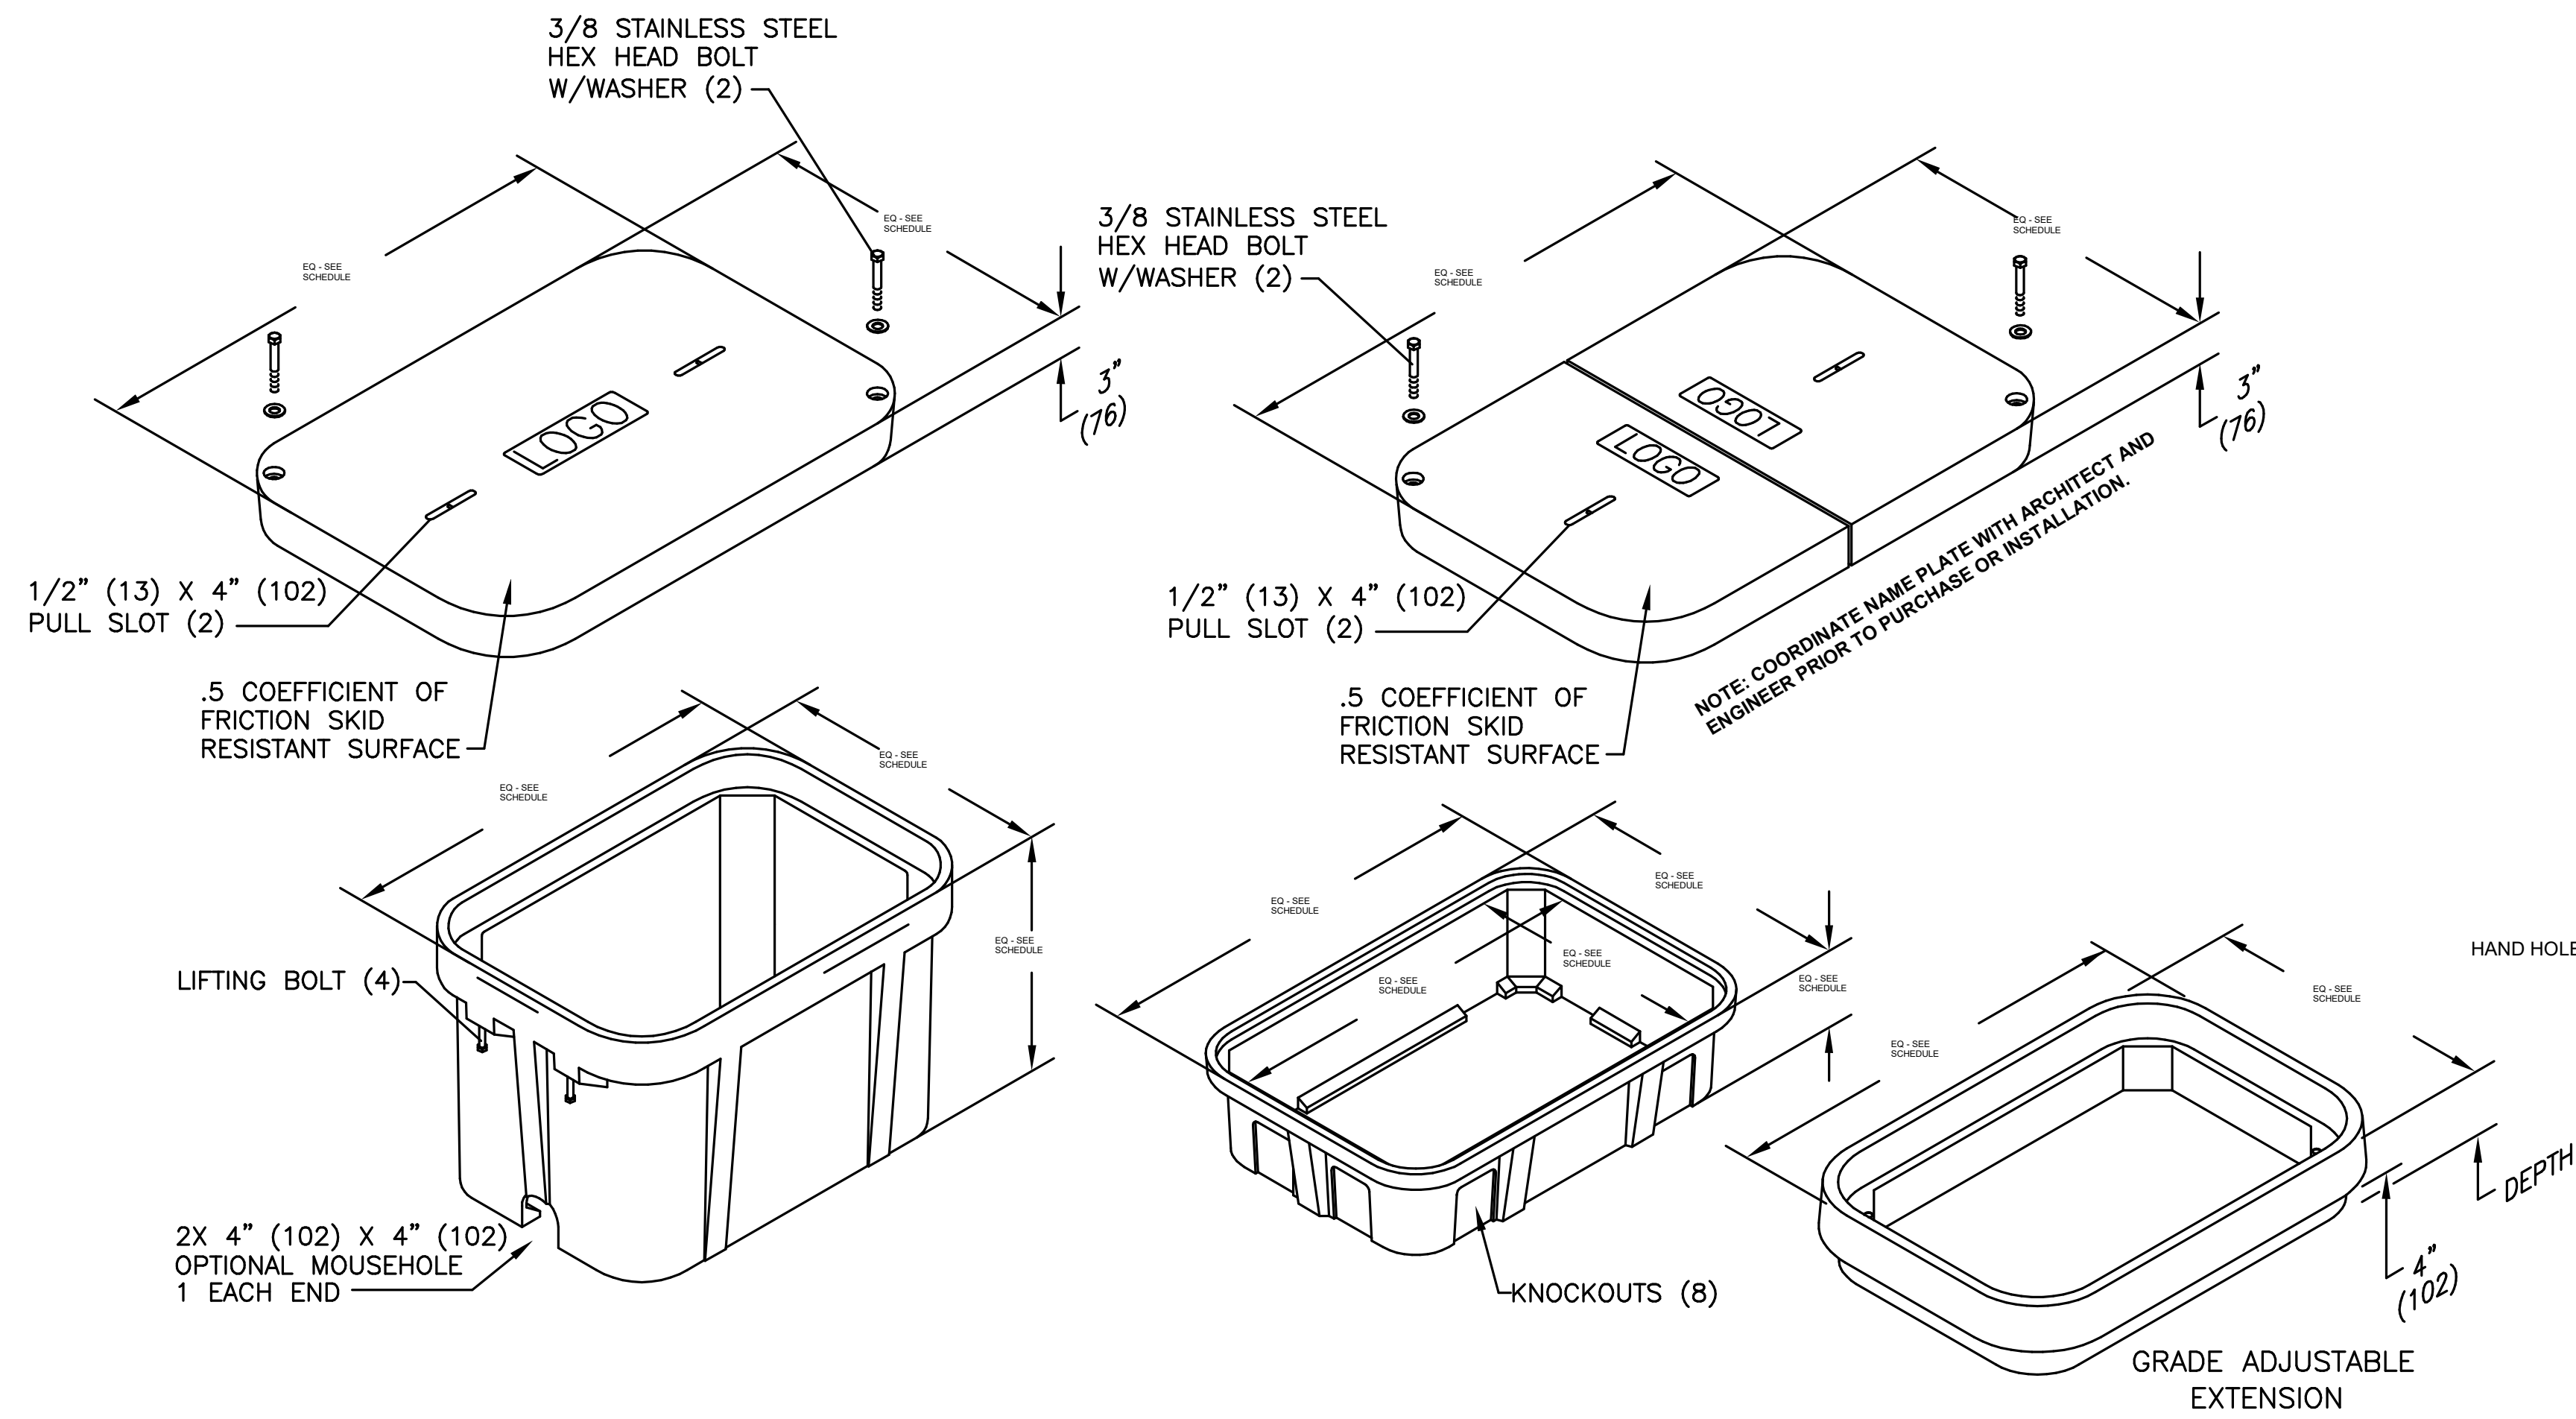

WELKER TRAILHEAD IMPROVEMENTS

2700 NORTH 2125 EAST
LAYTON, UT 84041

REVISIONS

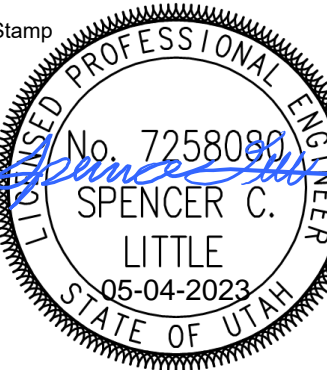

Designed By: JUN
Drawn By: JUN
Date: 04/26/2023
Checked By: SCL
Project No: 230019

Drawing Title
SITE JUNCTION BOX DETAILS


Drawing number

ES505

A1 TYPICAL UNDERGROUND JUNCTION BOX DETAIL

SCALE: NTS

BID SET

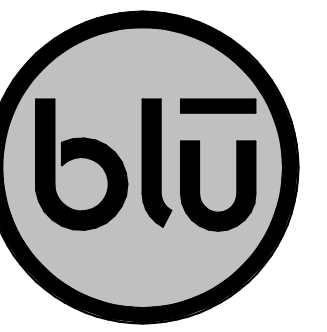

blu line designs
planning | landscape architecture | design

8710 S. Sandy Parkway
Sandy, UT 84070
p 801.679.3157


OWNER:
LAYTON CITY
437 N WASATCH DR.
LAYTON, UT 84041

CONTACT:
JOELLEN GRANDY
PH: 801-336-3926

WELKER TRAILHEAD IMPROVEMENTS
2700 NORTH 2125 EAST
LAYTON, UT 84041

REVISIONS

NO.	DATE	DESCRIPTION

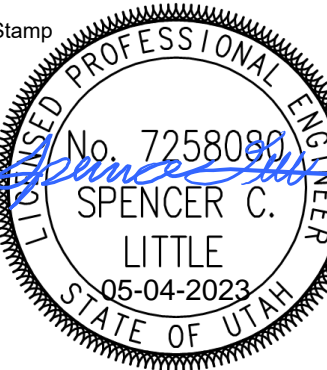

Designed By: JUN
Drawn By: JUN
Date: 04/26/2023
Checked By: SCL
Project No: 230019

Drawing Title
ELECTRICAL
SITE LIGHTING
DETAILS AND
SCHEDULES


Drawing number

ES508

LIGHT POLE PIER FOOTING SCHEDULE¹


WIND SPEED (mph)	MAX EPA (FT ³)	LIGHT POLE HEIGHT (ft)	LIGHT POLE DIA (in) max	FOOTING DIAMETER, d (in)	h=MIN FOUNDATION ² EMBED. (ft)	VERTICAL REINF. BAR SIZE	VERTICAL BAR QUANTITY	CIRC. TIE BAR SIZE	CIRC. TIE SPACING (in)
120	2	30	8	24	7'-6"	#5	8	#4	12" O.C.
120	2	25	8	24	6'-6"	#5	8	#4	12" O.C.
120	2	20	8	24	6'-0"	#5	8	#4	12" O.C.
120	2	15	8	24	5'-0"	#5	8	#4	12" O.C.
120	2	10	8	24	4'-6"	#5	8	#4	12" O.C.
120	2	30 ³	8	18	-	-	-	-	-
120	2	25 ³	8	18	-	-	-	-	-
120	2	20	8	18	6'-0"	#5	5	#4	12" O.C.
120	2	15	8	18	5'-0"	#5	5	#4	12" O.C.
120	2	10	8	18	4'-6"	#5	5	#4	12" O.C.
120	2	30 ³	6	16	-	-	-	-	-
120	2	25 ³	6	16	-	-	-	-	-
120	2	20	6	16	6'-6"	#5	4	#4	12" O.C.
120	2	15	6	16	5'-6"	#5	4	#4	12" O.C.
120	2	10	6	16	4'-6"	#5	4	#4	12" O.C.

NOTE:
 1. CONTRACTOR SHALL SUBMIT DEFERRED SUBMITTAL FOR LIGHT POST FOOTING TO ENGINEER OF RECORD. SCHEDULE ABOVE IS FOR BIDDING PURPOSES ONLY.
 2. SCHEDULE ABOVE ASSUMES CLAY OR SILT SOIL CONDITIONS WITH SEISMIC CLASS D AND DEFAULT SOIL PARAMETERS FROM IBC SECTION 1806.2
 3. EXCEEDS THE MAXIMUM BEARING CAPACITY OF 1500 PSF. VERIFY ALLOWABLE SOIL BEARING WITH SOILS REPORT.
 4. TOP SOIL SHALL NOT BE USED TO RESIST LATERAL LOAD IN FOOTING. THE EMBED DEPTH IN THE TABLE SHALL BE BEGIN BELOW THE BASE OF THE TOP SOIL AS SHOWN IN THE ELEVATION.
 5. SECTION VIEW IS FOR VISUAL REPRESENTATION ONLY. VERIFY BAR QUANTITY WITH SCHEDULE 60,000 PSI REBAR YIELD STRENGTH
 6. CONCRETE MIX SHALL BE FOR EXTERIOR CONCRETE SUBJECT TO FREEZE THAW CONATIONS WITH THE MINIMUM PROPERTIES.
 A. 3000 PSI
 B. TYPE II PORTLAND CEMENT
 C. WATER TO CEMENT RATIO = 0.5%
 D. AIR ENTRAINMENT = 5%
 E. MAX AGGREGATE SIZE= 1"
 F. CONCRETE EXPOSURE CLASS= F2, S0, C1
 G. 4" SLUMP BEFORE ADDITION OF PLASTICIZER

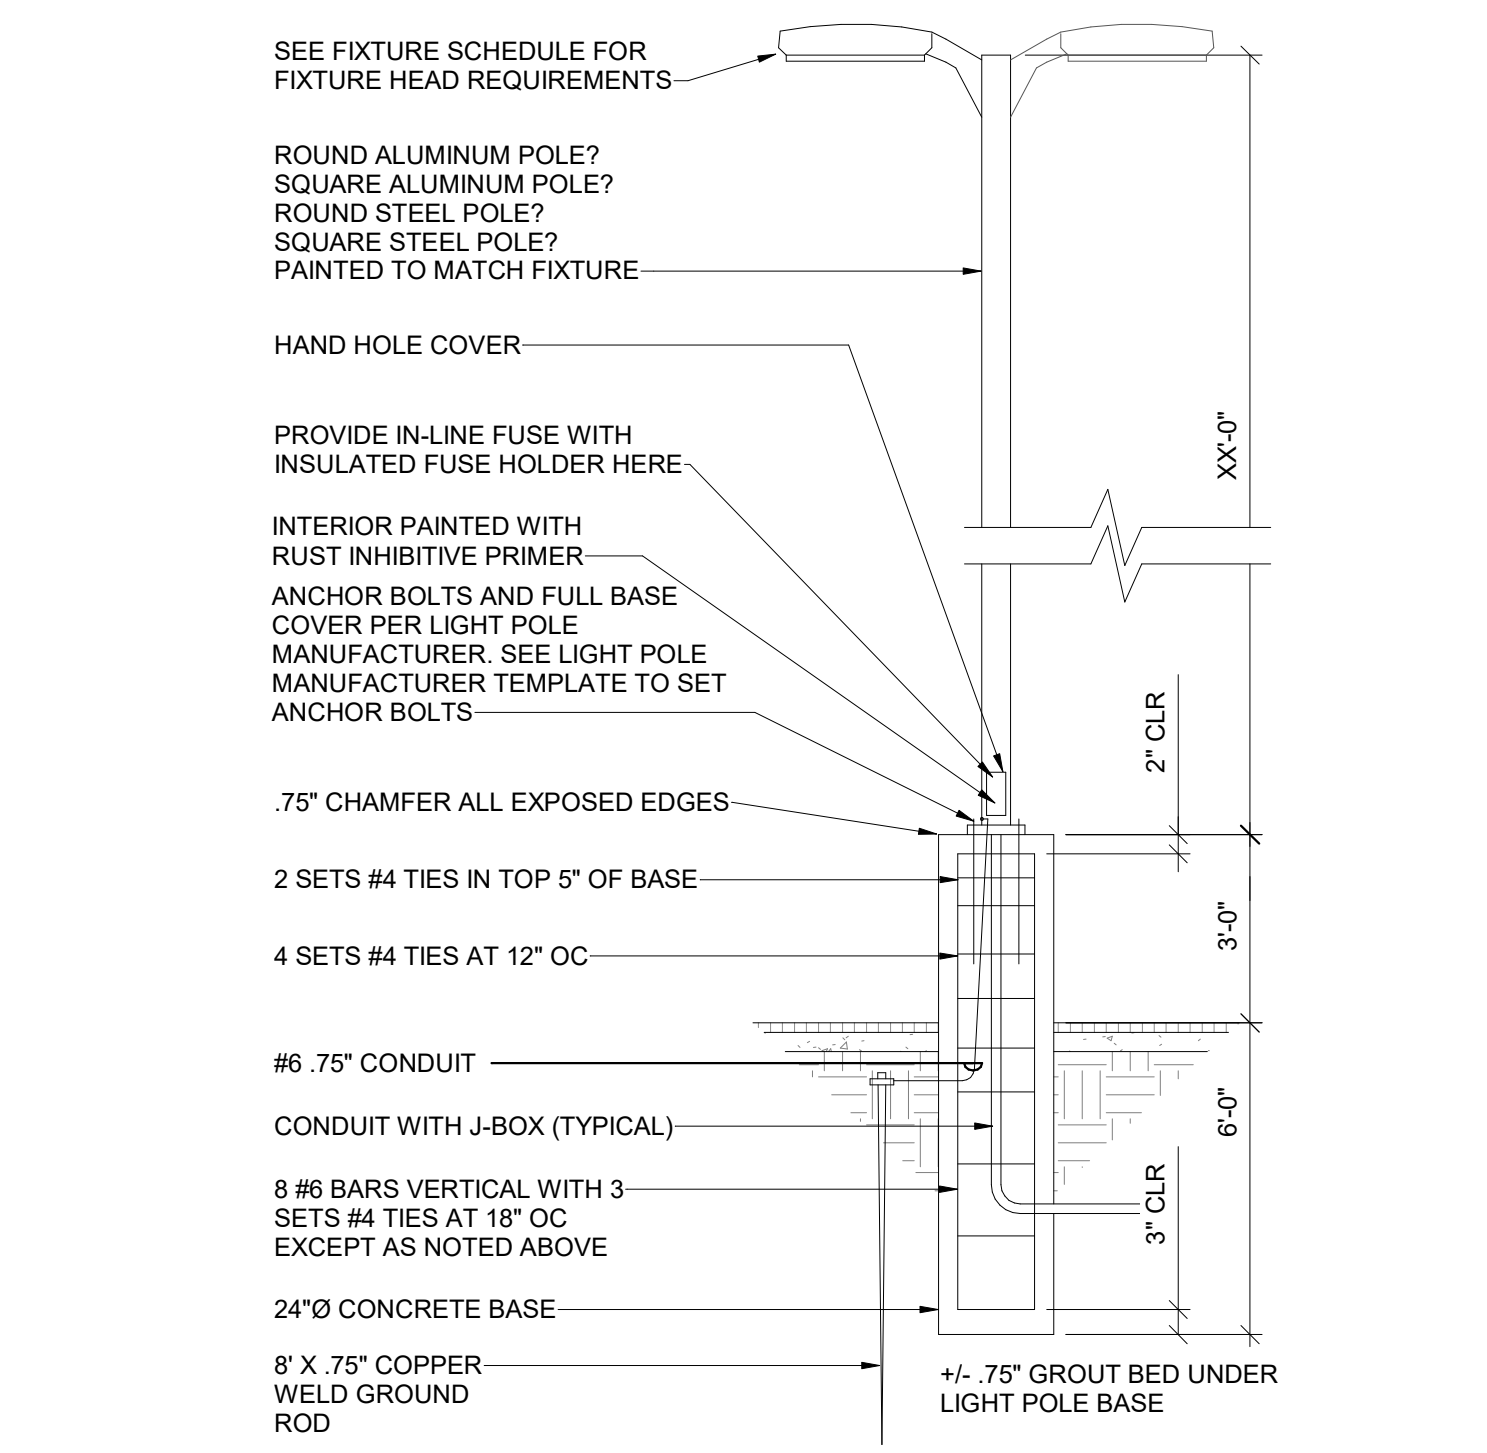

2 PARKING LOT LIGHT POLE BASE DETAIL
SCALE: NTS

1 TYPICAL LIGHT POLE FOOTING SCHEDULE
SCALE: NTS

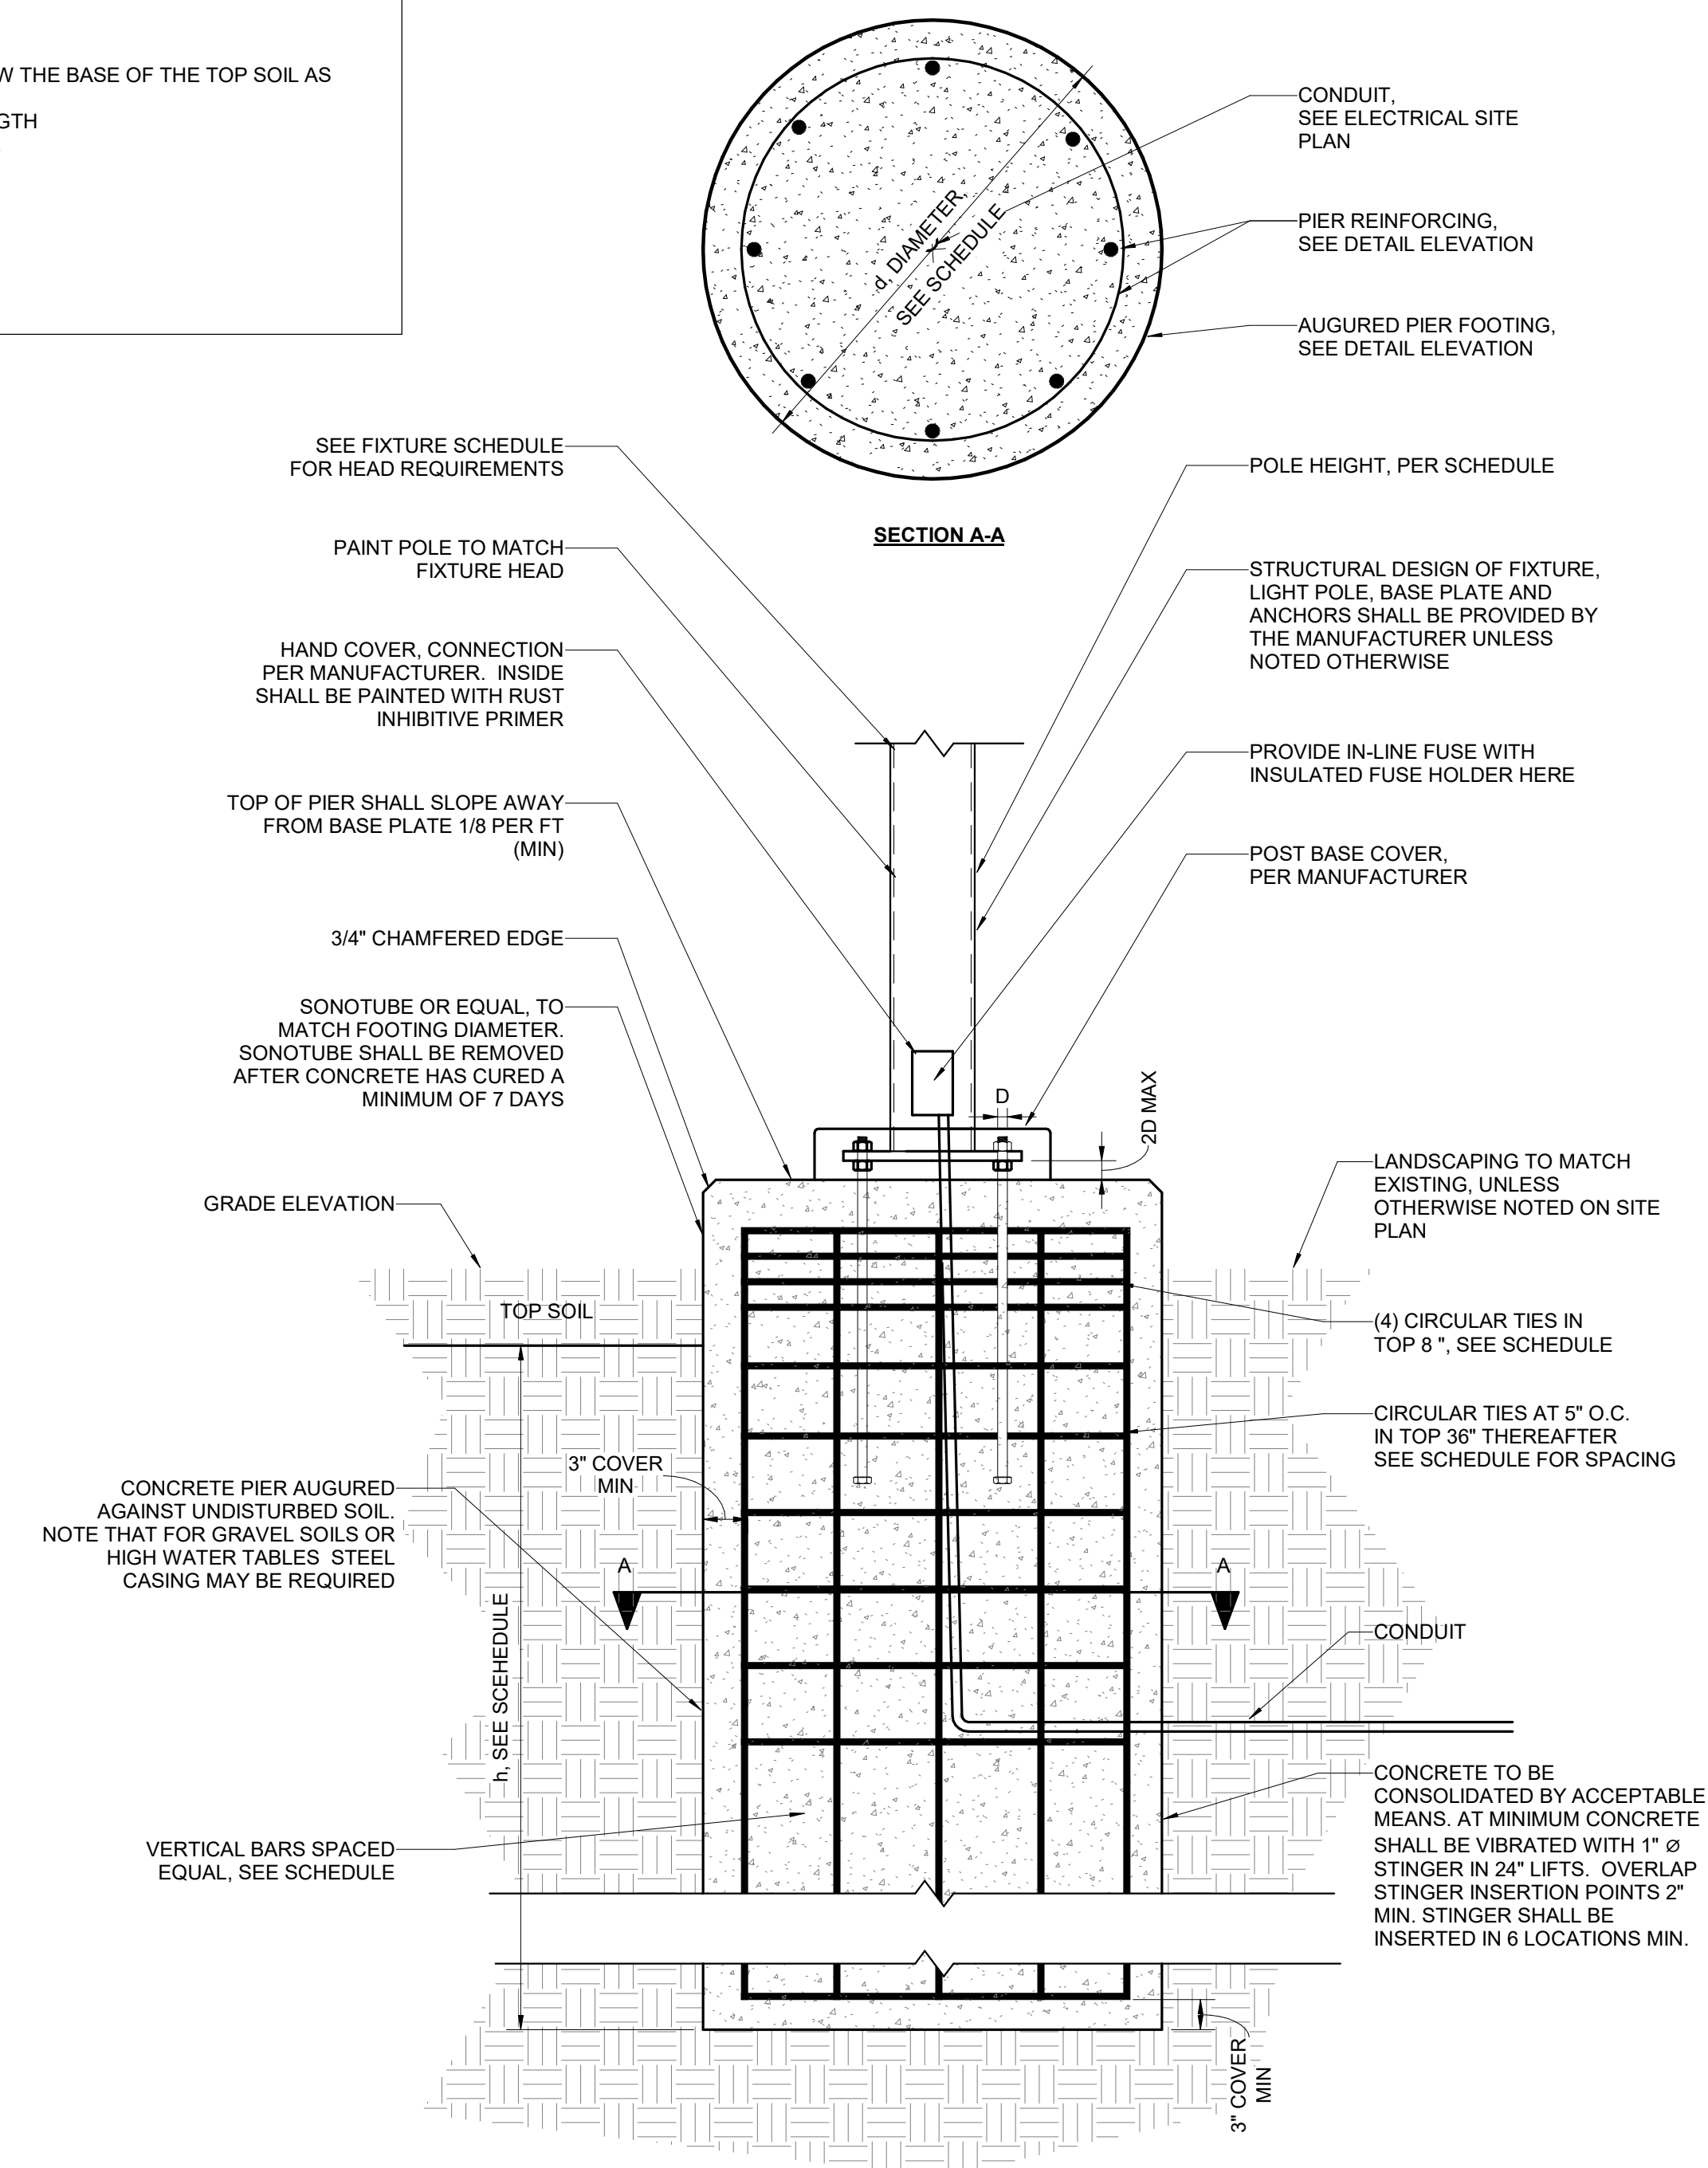

BID SET

PANEL: "1LA"																			
VOLTS/PHASE/WIRE:			PANEL SIZE & TYPE:			MAIN SIZE AND TYPE:			FED FROM:		CABINET:		LOCATION:		NOTES:				
120/240 V, 1 PH 3 WIRE			22" W x 6" D, BOLT-ON			125 AMPERE			CT		SURFACE								
ACCESSORIES: PANEL DIRECTORY, IDENTIFICATION, GROUNDING BAR																			
AIC RATING:																			
CKT	NO	AMP	POLE	BKR	LGTG	PWR	CO	PHASE LOAD			DESCRIPTION	CO	PWR	LGTG	BKR	POLE	AMP	CKT NO	
								A	B	C									
1	20	1			0.1	0.0	0.0										1	20	2
3	20	1															1	20	4
5	20	1															1	20	6
7	20	1															1	20	8
9	20	1															1	20	10
11	20	1															1	20	12
13	20	1															1	20	14
15	20	1															1	20	16
17	20	1															1	20	18
19	20	1															1	20	20
21	20	1															1	20	22
23	20	1															1	20	24
25	20	1															1	20	26
27	20	1															1	20	28
29	20	1															1	20	30
31	20	1															1	20	32
33	20	1															1	20	34
35	20	1															1	20	36
37	20	1															1	20	38
39	20	1															1	20	40
41	20	1															1	20	42
TOTALS:								CONNECTED KVA PER PHASE	0	0	0	CONNECTED TOTAL KVA =			0				
								CONNECTED AMPS PER PHASE	1	0	0	AVERAGE CONNECTED AMPS PER PHASE =			1				
NEC DIVERSIFIED LOAD CALCULATIONS																			
LIGHTING & CONTINUOUS LOADS: 0.1 kVA @ 125% = 0.2 kVA - 100% CONNECTED LOAD PLUS 25% DIVERSIFIED TOTAL kVA = 0																			
RECEPTACLES: - FIRST 10kVA @ 100%, REMAINDER @ 50% AVERAGE AMPS PER PHASE = 1																			
ALL OTHER LOADS @ 100%: 0.0 kVA - MOTOR TOTALS INCLUDED IN ALL OTHER LOADS WITH LARGEST MOTOR CALCULATED @ 125% PER NEC																			
BKR: GF=GFCI, GF3=30mA GFCI CAPABLE OF BEING LOCKED OUT IN OPEN POSITION, IG=ISOLATED GROUND, AF=AFCI, ST=SHUNT TRIP, RED=PROVIDE RED COLORED BREAKER, AF=ARC FAULT CURRENT INTERRUPTER, GA=COMBINATION OF GROUND FAULT AND ARC FAULT CIRCUIT INTERRUPTER, GS=COMBINATION OF SHUNT TRIP WITH GFCI																			

EQUIPMENT NAMEPLATE SCHEDULE			
EQUIPMENT ID SCHEME	FIRST DIGIT - BUILDING LEVEL (0, 1, 2, ETC) SECOND DIGIT - PANEL TYPE M - MECHANICAL H - (277/480) L - (120/208) E - EMERGENCY S - STANDBY O - EQUIPMENT U - UPS K - KITCHEN (120/208) THIRD DIGIT - BUILDING AREA (A, B, C, ETC) FOURTH DIGIT - SEQUENCE # (1,2,3,...)		
LABEL FORMAT	[NAME] [SYSTEM] [VOLTAGE] [FED FROM] [SOURCE(S)]		
LABEL EXAMPLE	PANEL "4LA1" STANDBY POWER 120/208V FED FROM BUS-A / XFMR 4TA		
BUSWAY	LABEL BUSWAY EVERY 6' WHERE EXPOSED TO VIEW AND EVERY 15' WHERE NOT EXPOSED TO VIEW		
OTHER			

COPPER CONDUCTOR AND CONDUIT SCHEDULE									
SYM	AMP	HH AMPS	CONDUIT SIZE	CONDUCTOR (NOTE 1)			IGHH	SE	NOTES
				QTY	SIZE	G			
1	20	-	75	2	12	12	12	8	2
2	20	-	75	3	12	12	12	8	2,3
3	20	24	75	4	12	12	12	8	2,3
4	30	-	75	2	10	10	10	8	2
5	30	-	75	3	10	10	10	8	2
6	30	32	75	4	10	10	10	8	2
7	40	-	1	2	8	10	8	6	2
8	40	-	1	3	8	10	8	6	2
9	40	44	1	4	8	10	8	6	2
10	55	-	1	2	6	10	8	4	2
11	55	-	1	3	6	10	8	4	2
12	55	60	1.25	4	6	10	8	4	2
13	70	-	1	2	4	8	4	2	2
14	70	-	1.25	3	4	8	4	2	2
15	70	76	1.25	4	4	8	4	2	2
16	85	-	1.25	2	3	8	3	2	2
17	85	-	1.25	3	3	8	3	2	2
18	85	92	1.25	4	3	8	3	2	2
19	95	-	1.25	3	2	8	2	2	2
20	95	104	1.50	4	2	8	2	2	2
21	130	-	1.50	3	1	6	2	2	2
22	130	116	1.50	4	1	6	2	2	2
23	150	-	2	3	10	6	2	10	2
24	150	136	2	4	10	6	2	10	2
25	175	-	2	3	20	6	2	20	2
26	175	156	2	4	20	6	2	20	2
27	200	-	2	3	30	6	2	20	2
28	200	180	2.50	4	30	6	2	20	2
29	230	-	2.50	3	40	4	2	20	2
30	230	208	2.50	4	40	4	2	20	2
31	255	-	2.50	3	250	4	1	20	2
32	255	232	2.50	4	250	4	1	20	2
33	310	-	3	3	350	3	1/0	30	2
34	310	280	3	4	350	3	1/0	30	2
35	380	-	3.50	3	500	3	3/0	30	2
36	380	344	4	4	500	3	3/0	30	2
37	400	-	2 EA 2	3	30	3	3/0	30	2
38	400	360	2 EA 2.50	4	30	3	3/0	30	2
39	510	-	2 EA 2.50	3	250	1	4/0	30	2
40	510	464	2 EA 3	4	250	1	4/0	30	2
41	620	-	2 EA 3	3	350	1/0	4/0	30	2,4
42	620	560	2 EA 3	4	350	1/0	4/0	30	2,4
43	760	-	2 EA 3.50	3	500	1/0	4/0	30	2,4
44	760	688	2 EA 4	4	500	1/0	4/0	30	2,4
45	855	-	3 EA 3	3	300	2/0	40	30	2,4
46	855	768	3 EA 3	4	300	2/0	40	30	2,4
47	1000	-	3 EA 3.50	3	400	2/0	40	30	4
48	1000	912	3 EA 3.50	4	400	2/0	40	30	4
49	1140	-	3 EA 4	3	500	3/0	40	30	4
50	1140	1032	3 EA 4	4	500	3/0	40	30	4
51	1240	-	4 EA 3	3	350	3/0	40	30	4
52	1240	1120	4 EA 3	4	350	3/0	40	30	4
53	1675	1520	5 EA 4	4	400	4/0	40	40	4
54	2010	1824	6 EA 4	4	400	250	250	250	4
55	2660	2408	7 EA 4	4	500	350	350	350	4
56	3040	2752	8 EA 4	4	500	500	500	500	4
57	4180	3784	11 EA 4	4	500	500	500	500	4
58	-	-	5 EA 4	-	-	-	-	-	6
59	-	-	5	-	-	-	-	-	6
60	-	-	10 EA 4	-	-	-	-	-	6

BRANCH CIRCUIT CONDUCTOR AND CONDUIT SIZING TABLE				
CIRCUIT AMPACITY/VOLTAGE	CIRCUIT LENGTH	CONDUCTOR SIZE (PHASE, NEUTRAL AND GR)	CONDUIT SIZE	
20A/120V	0' - 50'	#12 AWG	0.75" Ø	
20A/120V	60' - 95'	#10 AWG	0.75" Ø	
20A/120V	95' - 150'	#8 AWG	1" Ø	
20A/120V	150' - 240'	#6 AWG	1.25" Ø	
20A/277V	0' - 140'	#12 AWG	0.75" Ø	
20A/277V	140' - 220'	#10 AWG	0.75" Ø	
20A/277V	220' - 350'	#8 AWG	1" Ø	
20A/277V	350' - 550'	#6 AWG	1.25" Ø	

NOTES:
1. WIRE SIZING IS BASED ON COPPER CONDUCTORS SUPPLYING A 20A, 120V CIRCUIT AT THE INDICATED VOLTAGE, ASSUMED TO BE 80% LOAD (16A), WITH MAXIMUM VOLTAGE DROP OF 3% AT THE LOAD.
2. DOWN-SIZE WIRE AT DEVICE/LOAD AS REQUIRED AND TERMINATE CONDUCTORS IN A SAFE AND CODE COMPLIANT MANNER.
3. CONDUIT SIZE IS BASED ON A MAXIMUM OF 3 CIRCUITS PER CONDUIT, EACH WITH A SEPARATE NEUTRAL CONDUCTOR.

COLOR SCHEME		NAMEPLATE COLOR	
SYSTEM	EQUIPMENT	TEXT	BACKGROUND
NORMAL POWER	ALL GEAR NOT INCLUDED BELOW	WHITE	BLACK
STANDBY POWER	MDP51 AND ALL DOWNSTREAM GEAR, WHITE EXCEPT UPS GEAR AS NOTED	WHITE	ORANGE
EMERGENCY POWER	GDP1, GDP2, ATS-E AND ALL DOWNSTREAM GEAR	WHITE	RED
LEGALLY-REQUIRED STANDBY POWER	ATS-S AND ALL DOWNSTREAM GEAR	RED	WHITE
UPS "A" POWER	UPSA AND ALL DOWNSTREAM GEAR	WHITE	BLUE
UPS "B" POWER	UPSB AND ALL DOWNSTREAM GEAR	BLACK	YELLOW


CONDUIT AND CONDUCTOR SCHEDULE NOTES
1. CONDUCTORS SHOWN ARE SHOWN FOR EACH CONDUIT WITH MODIFICATIONS AS NOTED IN NOTE 5. ALL CONDUCTORS SHOWN ARE THWN UNLESS OTHERWISE NOTED.
2. PROVIDE EQUIPMENT GROUND CONDUCTORS PER TABLE 250-122 WHEN CIRCUIT BREAKERS ARE SIZED GREATER THAN AMPERE RATING SHOWN IN TABLE.
3. PROVIDE #10 NEUTRALS FOR MULTIWIRED BRANCH CIRCUITS SERVING COMPUTERS.
4. GROUND (G) CONDUCTOR MAY BE DELETED ON SERVICE ENTRANCE CONDUCTORS.
5. SYMBOL SUBSCRIPTS:
"2N": INCLUDE TWO NEUTRAL CONDUCTORS, SIZED AS SCHEDULED FOR PHASED AND NEUTRAL CONDUCTORS.
"FG": FULL SIZE GROUND, SIZE EQUIPMENT GROUNDING CONDUCTOR TO BE SAME SIZE AS THE PHASE CONDUCTORS.
"HH": NEUTRAL CURRENTS EXIST DUE TO HIGH HARMONIC "NONLINEAR" LOADS. CURRENT CARRYING CONDUCTORS DERATED ACCORDINGLY. PROVIDE THE IGHH SIZE FOR THE EQUIPMENT GROUNDING CONDUCTOR.
"IG": INCLUDE IG (INSULATED/ISOLATED GROUND CONDUCTOR) SCHEDULED ALONG WITH THE GROUND OF EQUIPMENT GROUND CONDUCTOR.
"SE": SUBSTITUTE "SE" CONDUCTOR FOR "G" CONDUCTOR SHOWN, WHICH IS SIZED FOR THE GROUNDING OF THE SECONDARY OF THE SEPARATELY DERIVED SYSTEM.
6. RACEWAY ONLY. CONDUCTORS PROVIDED BY UTILITY.

GENERAL SHEET NOTES


- CONTRACTOR IS RESPONSIBLE FOR ALL LINE VOLTAGE AS PART OF THIS PROJECT. PROVIDE LINE VOLTAGE REQUIRED TO ALL SYSTEMS PROVIDED AS PART OF THIS PROJECT. COORDINATE WITH ALL OTHER DISCIPLINES AND DRAWINGS.
- CONTRACTOR IS RESPONSIBLE FOR ALL DEVICES, GEAR, CABLE, CONDUCTORS, TERMINATIONS, OVERCURRENT PROTECTION DEVICES, AND HEAD END EQUIPMENT AS PART OF THIS PROJECT.
- PROVIDE ELECTRICAL CONNECTION TO MOTORIZED DOORS WITH ALL POWER AND CONTROL WIRING PER MANUFACTURERS WRITTEN INSTRUCTIONS. COORDINATE OPERATION OF DOORS WITH SECURITY, FIRE, AND SMOKE CONTROL SEQUENCES OF OPERATION.
- ELECTRICAL CONDUIT CONNECTIONS MADE TO EXPOSED JUNCTION BOXES ON UNITS SHOULD BE MADE ON THE BOTTOM OF THE BOX. INSTALLATION SHOULD COMPLY WITH LOCAL CODE REQUIREMENTS. THE INSTALLATION SHOULD BE MADE WATERTIGHT.
- WHERE AN EXTERNAL ELECTRICAL JUNCTION BOX IS NOT USED, WATERTIGHT FITTINGS SHOULD BE USED AT THE PANEL JOINT. IF ELECTRICAL CONDUIT PASSES THROUGH A HOLE IN THE PANEL, THAT JOINT SHOULD BE MADE WATERTIGHT.
- INSTALLATION SHALL BE IN ACCORDANCE WITH THE NEC "NATIONAL ELECTRICAL CODE."
- PROVIDE GFCI, HEAVY-DUTY, WEATHER RESISTANT OUTLET WITHIN 25' OF ALL EQUIPMENT. FIELD VERIFY EXISTING CONDITIONS AND PROVIDE ADDITIONAL DEVICE(S) AND CIRCUITING AS REQUIRED.
- ALL EXTERIOR OUTLETS SHALL BE CONTROLLED WITH RELAY TO TRUN POWER ON AND OFF FOR RESERVED FUNCTIONS.

SHEET KEYNOTES

- PROVIDE PANEL WITH GROUNDING AND MAIN BONDING JUMPER. REFER TO DETAIL (C1) ON SAME SHEET FOR MORE INFORMATION.

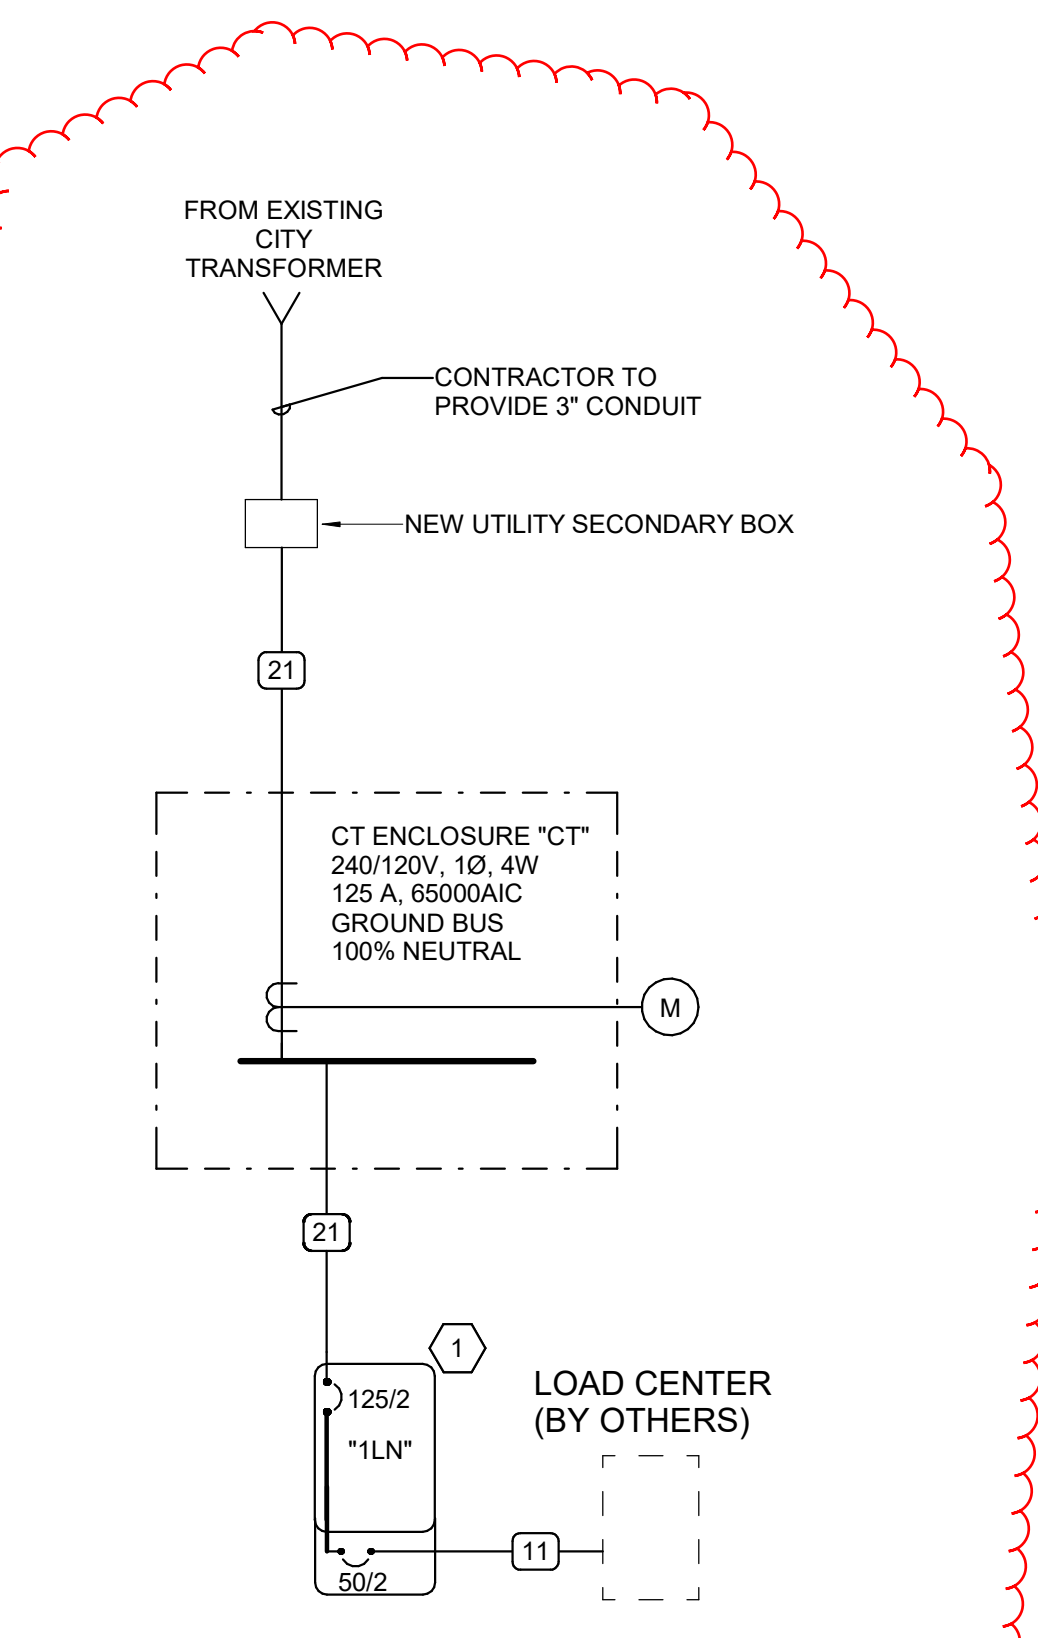

1 ONE LINE DIAGRAM
SCALE: NTS

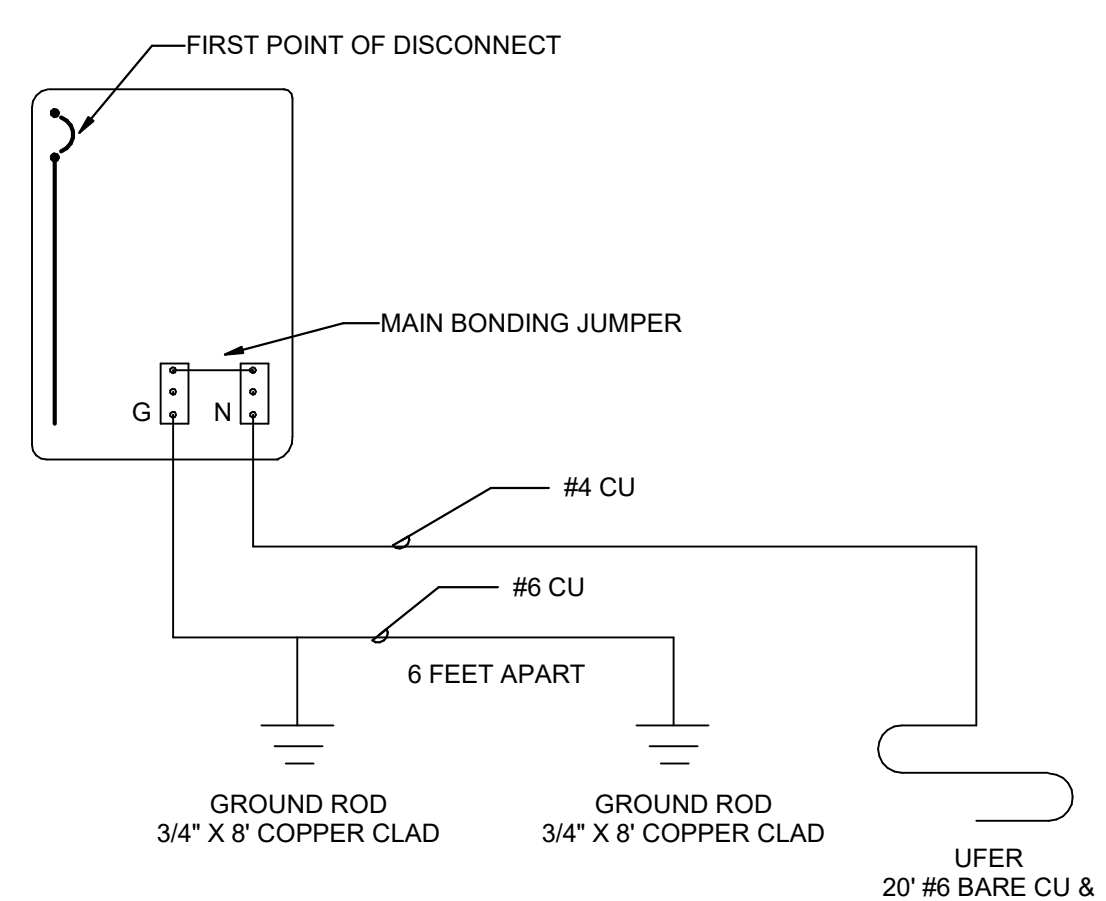

2 GROUNDING RISER DIAGRAM
SCALE: NTS




blu line designs
planning | landscape architecture | design
8710 S. Sandy Parkway
Sandy, UT 84070
p 801.679.3157


OWNER:
LAYTON CITY
437 N WASATCH DR.
LAYTON, UT 84041

CONTACT:
JOLEEN GRANDY
PH: 801-336-3926

WELKER TRAILHEAD IMPROVEMENTS
2700 NORTH 2125 EAST
LAYTON, UT 84041

REVISIONS	
NO.	DESCRIPTION

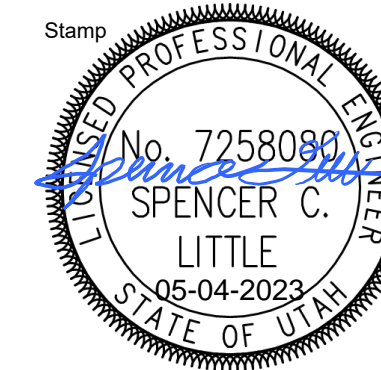

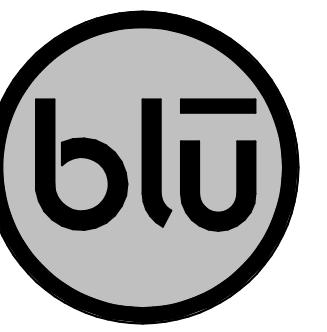

blu line designs
planning | landscape architecture | design

8710 S. Sandy Parkway
Sandy, UT 84070
p 801.679.3157

OWNER:
LAYTON CITY
437 N WASATCH DR.
LAYTON, UT 84041

CONTACT:
JOELLEN GRANDY
PH: 801-336-3926

EXTERIOR LIGHTING FIXTURE SCHEDULE

ABBREVIATIONS

LUMINAIRE

ARHR - AIR RETURN AND HEAT REJECTION
DL - DAMP LOCATION
EQC - EARTHQUAKE CLIPS
F - FUSING
HLD - HINGED AND LATCHED DOOR
HS - HOUSE SIDE SHIELD
PS - PHOTOCELL SWITCH
QRS - QUARTZ RESTRIKE
ST - STATIC
WG - WIRE GUARD
WL - WET LOCATION

EMERGENCY

NE - NORMAL AND EMERGENCY CONNECTIONS
EB - EMERGENCY BATTERY PACK
ET - EMERGENCY TRANSFER DEVICE

BALLAST

IS - INSTANT START
RS - RAPID START
PS - PROGRAM START, PARALLEL LAMP OPERATION
PSMH - PULSE START METAL HALLIDE (CWA OR ELECTRONIC)
PPLF - PROVIDE POWER LINE FILTER
LVTM - LOW VOLTAGE TRANSFORMER (MAGNETIC)
LVTE - LOW VOLTAGE TRANSFORMER (ELECTRONIC)

DIMMING BALLAST

D2 - 2 WIRE DIMMER
D3 - 3 WIRE DIMMER
D4 - 4 WIRE DIMMER
DD - DIGITAL DIMMER
SDP - STEP DIMMER BALLAST

FINISH

MW - MATTE WHITE
BL - BLACK
SL - SILVER
GOLD - GOLD
CL - CLEAR
PW - PAINTED WHITE
EA - EXTRUDED ALUMINUM
S - STEEL
GS - GALVANIZED STEEL
C - CAST
CBA - COLOR BY ARCHITECT
SCBA - STANDARD COLOR BY ARCHITECT
CCA - CUSTOM COLOR BY ARCHITECT
FS - MEETS FEDERAL STANDARD 209D
TP - THERMALLY PROTECTED
FL - FLUSH
R - REGRESS
M - MITERED

LENS

#A - ACRYLIC #THICK
#OA - ACRYLIC #THICK (OPAL)
GC - GLASS (CLEAR)
GO - GLASS (OPAL)
GF - GLASS (FROSTED)
SGL - SOFT GLOW LENS
HPL - HIGH PERFORMANCE LENS
DO - DROP OPAL
CGL - CONVEX GLASS LENS
S - SATIN LENS

REFLECTOR AND DISTRIBUTION

I - TYPE I
II - TYPE II
III - TYPE III
IV - TYPE IV
V - TYPE V
VSO - TYPE V SQUARE
SA - SPUN ALUMINUM
SR - SEGMENTED REFLECTOR
BWF - NEMA BEAM WIDTH 1 THRU 7

CUTOFF CLASSIFICATION

FC - FULL CUTOFF
CO - CUTOFF
SC - SEMI CUTOFF
NC - NONCUTOFF

MOUNTING

B - BASE
C - CEILING
F - FLANGE
G - GRID
P - PENDANT
PL - POLE
R - RECESSED
S - SURFACE
W - WALL

CONFIGURATION

BA - BANNER ARMS
BH - BULL HORN
DL - 2 1/2" SHAPE
DS - 2 @ 180
PT - INLINE POST TOP
Q - QUAD
SH - SHEPHERDS HOOK
SL - SINGLE
T - 3" T SHAPE

POLE

RS - ROUND STRAIGHT
RT - ROUND TAPERED
SS - SQUARE STRAIGHT
ST - SQUARE TAPERED

NOTES

- PROVIDE UNIT PRICES AND FIXTURE BRAND SELECTED FOR ADD/DELETE CHANGES FOR EACH FIXTURE TYPES SHOWN WITHIN 48 BUSINESS HOURS OF THE BID DATE. FAILURE TO COMPLY WITH THIS REQUIREMENT MAY DISQUALIFY THE PRODUCTS AND EMPOWER THE ENGINEER TO DETERMINE FAIR VALUE FOR FIXTURE AND INSTALLATION CHANGES, WITHOUT FURTHER INPUT FROM THE CONTRACTOR OR INSTALLER.
- CONTRACTOR ALLOWANCE PRICES ARE ACCURATE WHEN THIS JOB WAS SPECIFIED, CONTRACTOR AND ELECTRICAL DISTRIBUTOR SHALL VERIFY THIS ALLOWANCE AND REPORT ANY PROBLEMS TO THE ENGINEER BEFORE THE BID. ALLOWANCE PRICE MAY OR MAY NOT INCLUDE LAMP(S) OR FREIGHT AS NOTED, AND DO NOT INCLUDE ANY TAXES.

- VERIFY THE PROPER MOUNTING KITS OR ACCESSORIES TO FACILITATE INSTALLATION AS SHOWN AT EACH LOCATION ON THE DRAWINGS.
- COMPLY WITH THE "EXTERIOR LIGHTING" SECTION OF THE SPECIFICATIONS.
- REFER TO SPECIFICATIONS FOR IMPORTANT TECHNICAL REQUIREMENTS FOR LIGHTING FIXTURES, BALLASTS, AND LAMPS.
- ALL FIXTURES SHALL BE APPROVED BY UL OR ANOTHER ACCEPTABLE TESTING LAB FOR THE PURPOSE INTENDED AND WITH THE LAMP AND BALLAST PROPOSED.

ID	IMAGE	TYPE	BUG RATING					LUMINAIRE SIZE (NOMINAL)				LAMP		BALLAST		FINISH			DIFFUSER				REFLECTOR			MOUNTING				MANUFACTURER (CATALOG SERIES)			ALLOWANCE	
			BACK	UP	GLARE	LENGTH	WIDTH	DEPTH	DIAMETER / APERTURE	OPTIONS	COLOR	TYPE	LUMINAIRE LUMENS	INPUT VOLTS	ANSI WATTS	HOUSING	TRIM	OTHER	TYPE	FINISH	CONFIGURATION	OPTIONS	DISTRIBUTION TYPE	FINISH	EFFICIENCY	TYPE	CONFIGURATION	POLE BASE HEIGHT	POLE HEIGHT	WIND RATING	OPTIONS	OPTION 1		OPTION 2
(Z54)		MODERN STYLE, LED POLE LIGHT, 20' POLE					26"	14"		4000K	LED	12000		120	SCBA	SCBA	SCBA					V		0			3' - 0"	20' - 0"			SUPERIOR (SX11365)	ENERGY (HALO150)	ALCON (11410-D)	
(Z55)		MODERN STYLE, LED POLE LIGHT, 20' POLE, DIRECT BURIAL.					26"	14"		4000K	LED	15000	277	120	SCBA	SCBA	SCBA					FTW		0			3' - 0"	20' - 0"			FONROCHE (CK16)			

Change light to the following:


Lithonia DSX1 LED P3
40K T4M MVOLT SPA
DBLXD 25 FT. SQUARE
ALUMINUM HINGE
BASE POLE DBLXD
100MPH + GUSTS
WIND RATING.
Mounting: Pole, Pole
Base. Lamps LED
(102W)

WELKER TRAILHEAD IMPROVEMENTS

2700 NORTH 2125 EAST
LAYTON, UT 84041

REVISIONS

NO.	DATE	DESCRIPTION

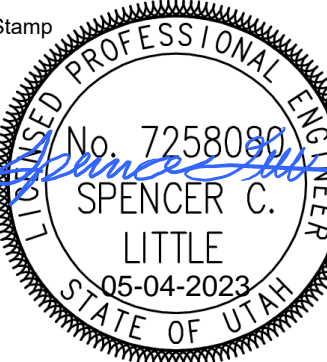

Designed By: JUN
Drawn By: JUN
Date: 04/26/2023
Checked By: SCL
Project No: Z30019

Drawing Title
EXTERIOR LIGHTING FIXTURE SCHEDULE

Drawing number

ES602

BID SET